


## AS-BUILT CONFIGURATION

OFFICES.....	3
RECEPTION.....	1
CONFERENCE ROOMS.....	N/A
KITCHEN.....	N/A
OPEN WORK AREA.....	+/-18

*Not to scale, furniture and appliances not included*

## KEY PLAN

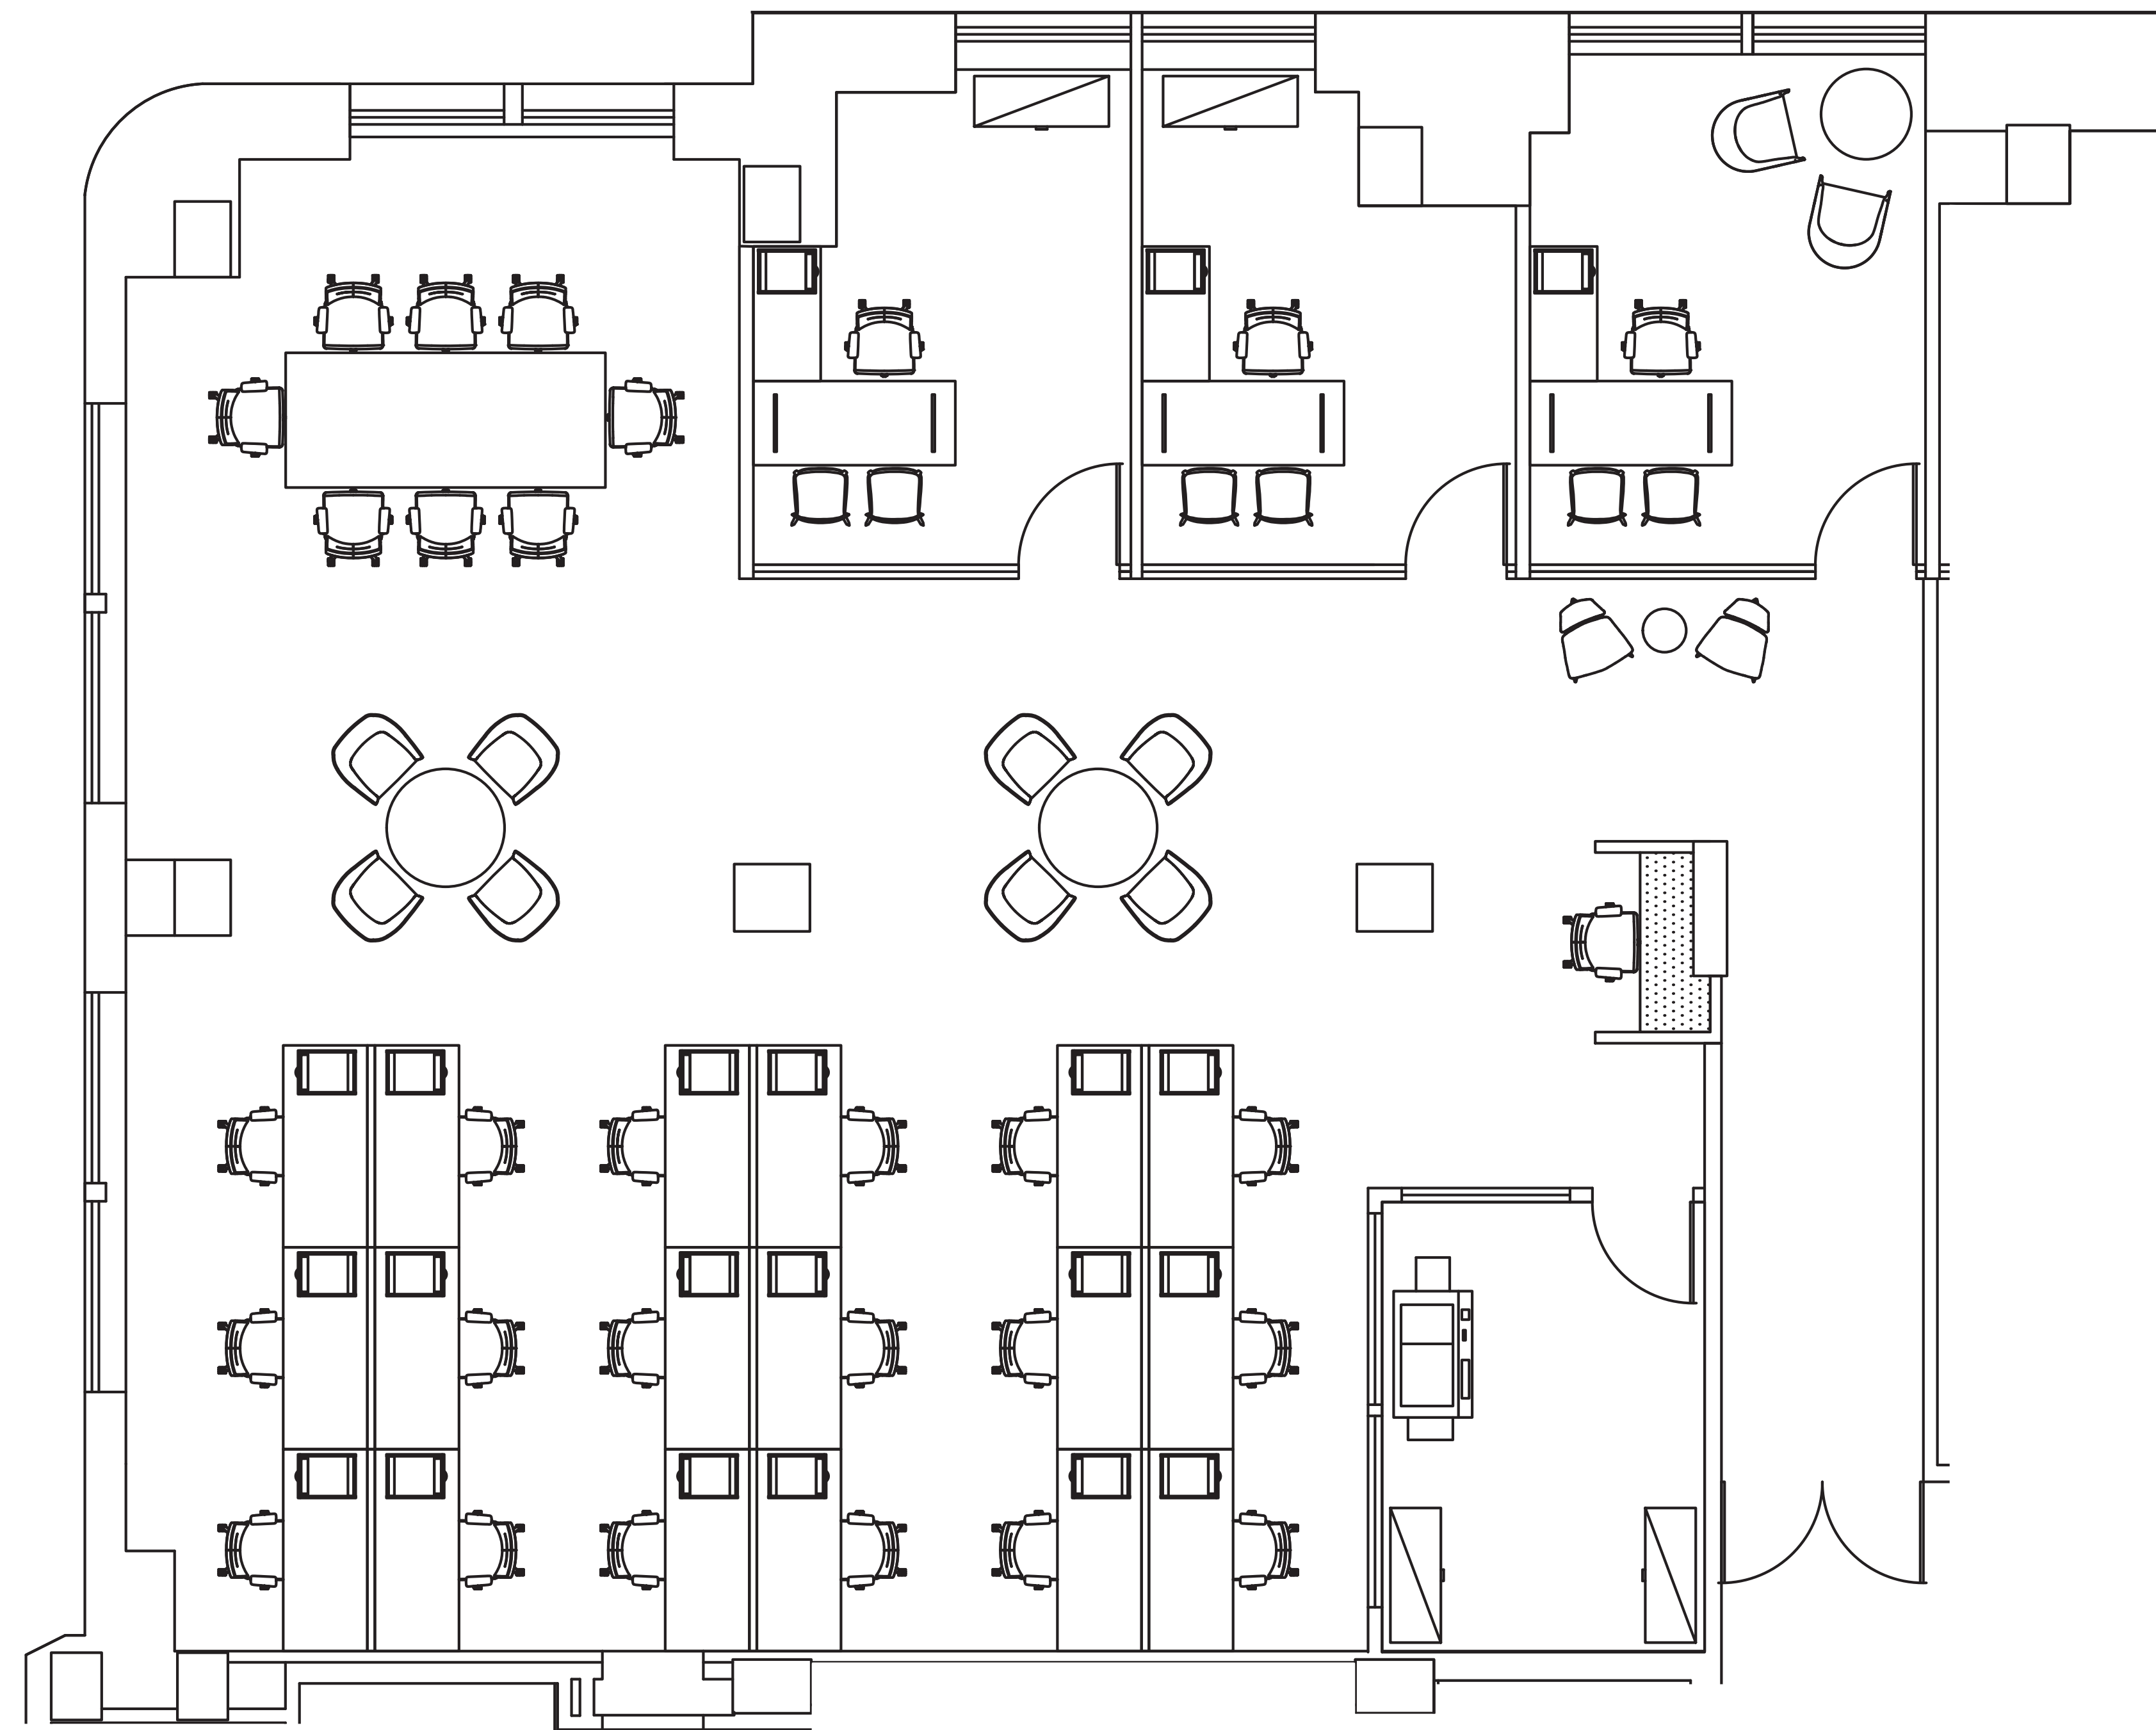

For leasing information please contact:

[USALEASING@ONNI.COM](mailto:USALEASING@ONNI.COM)

(213) 629-2041