


AS-BUILT CONFIGURATION

- OFFICES..... 5
- RECEPTION..... 1
- CONFERENCE ROOMS..... 1
- KITCHEN..... 1
- OPEN WORK AREA..... +/- 30

Not to scale, furniture and appliances not included

KEY PLAN

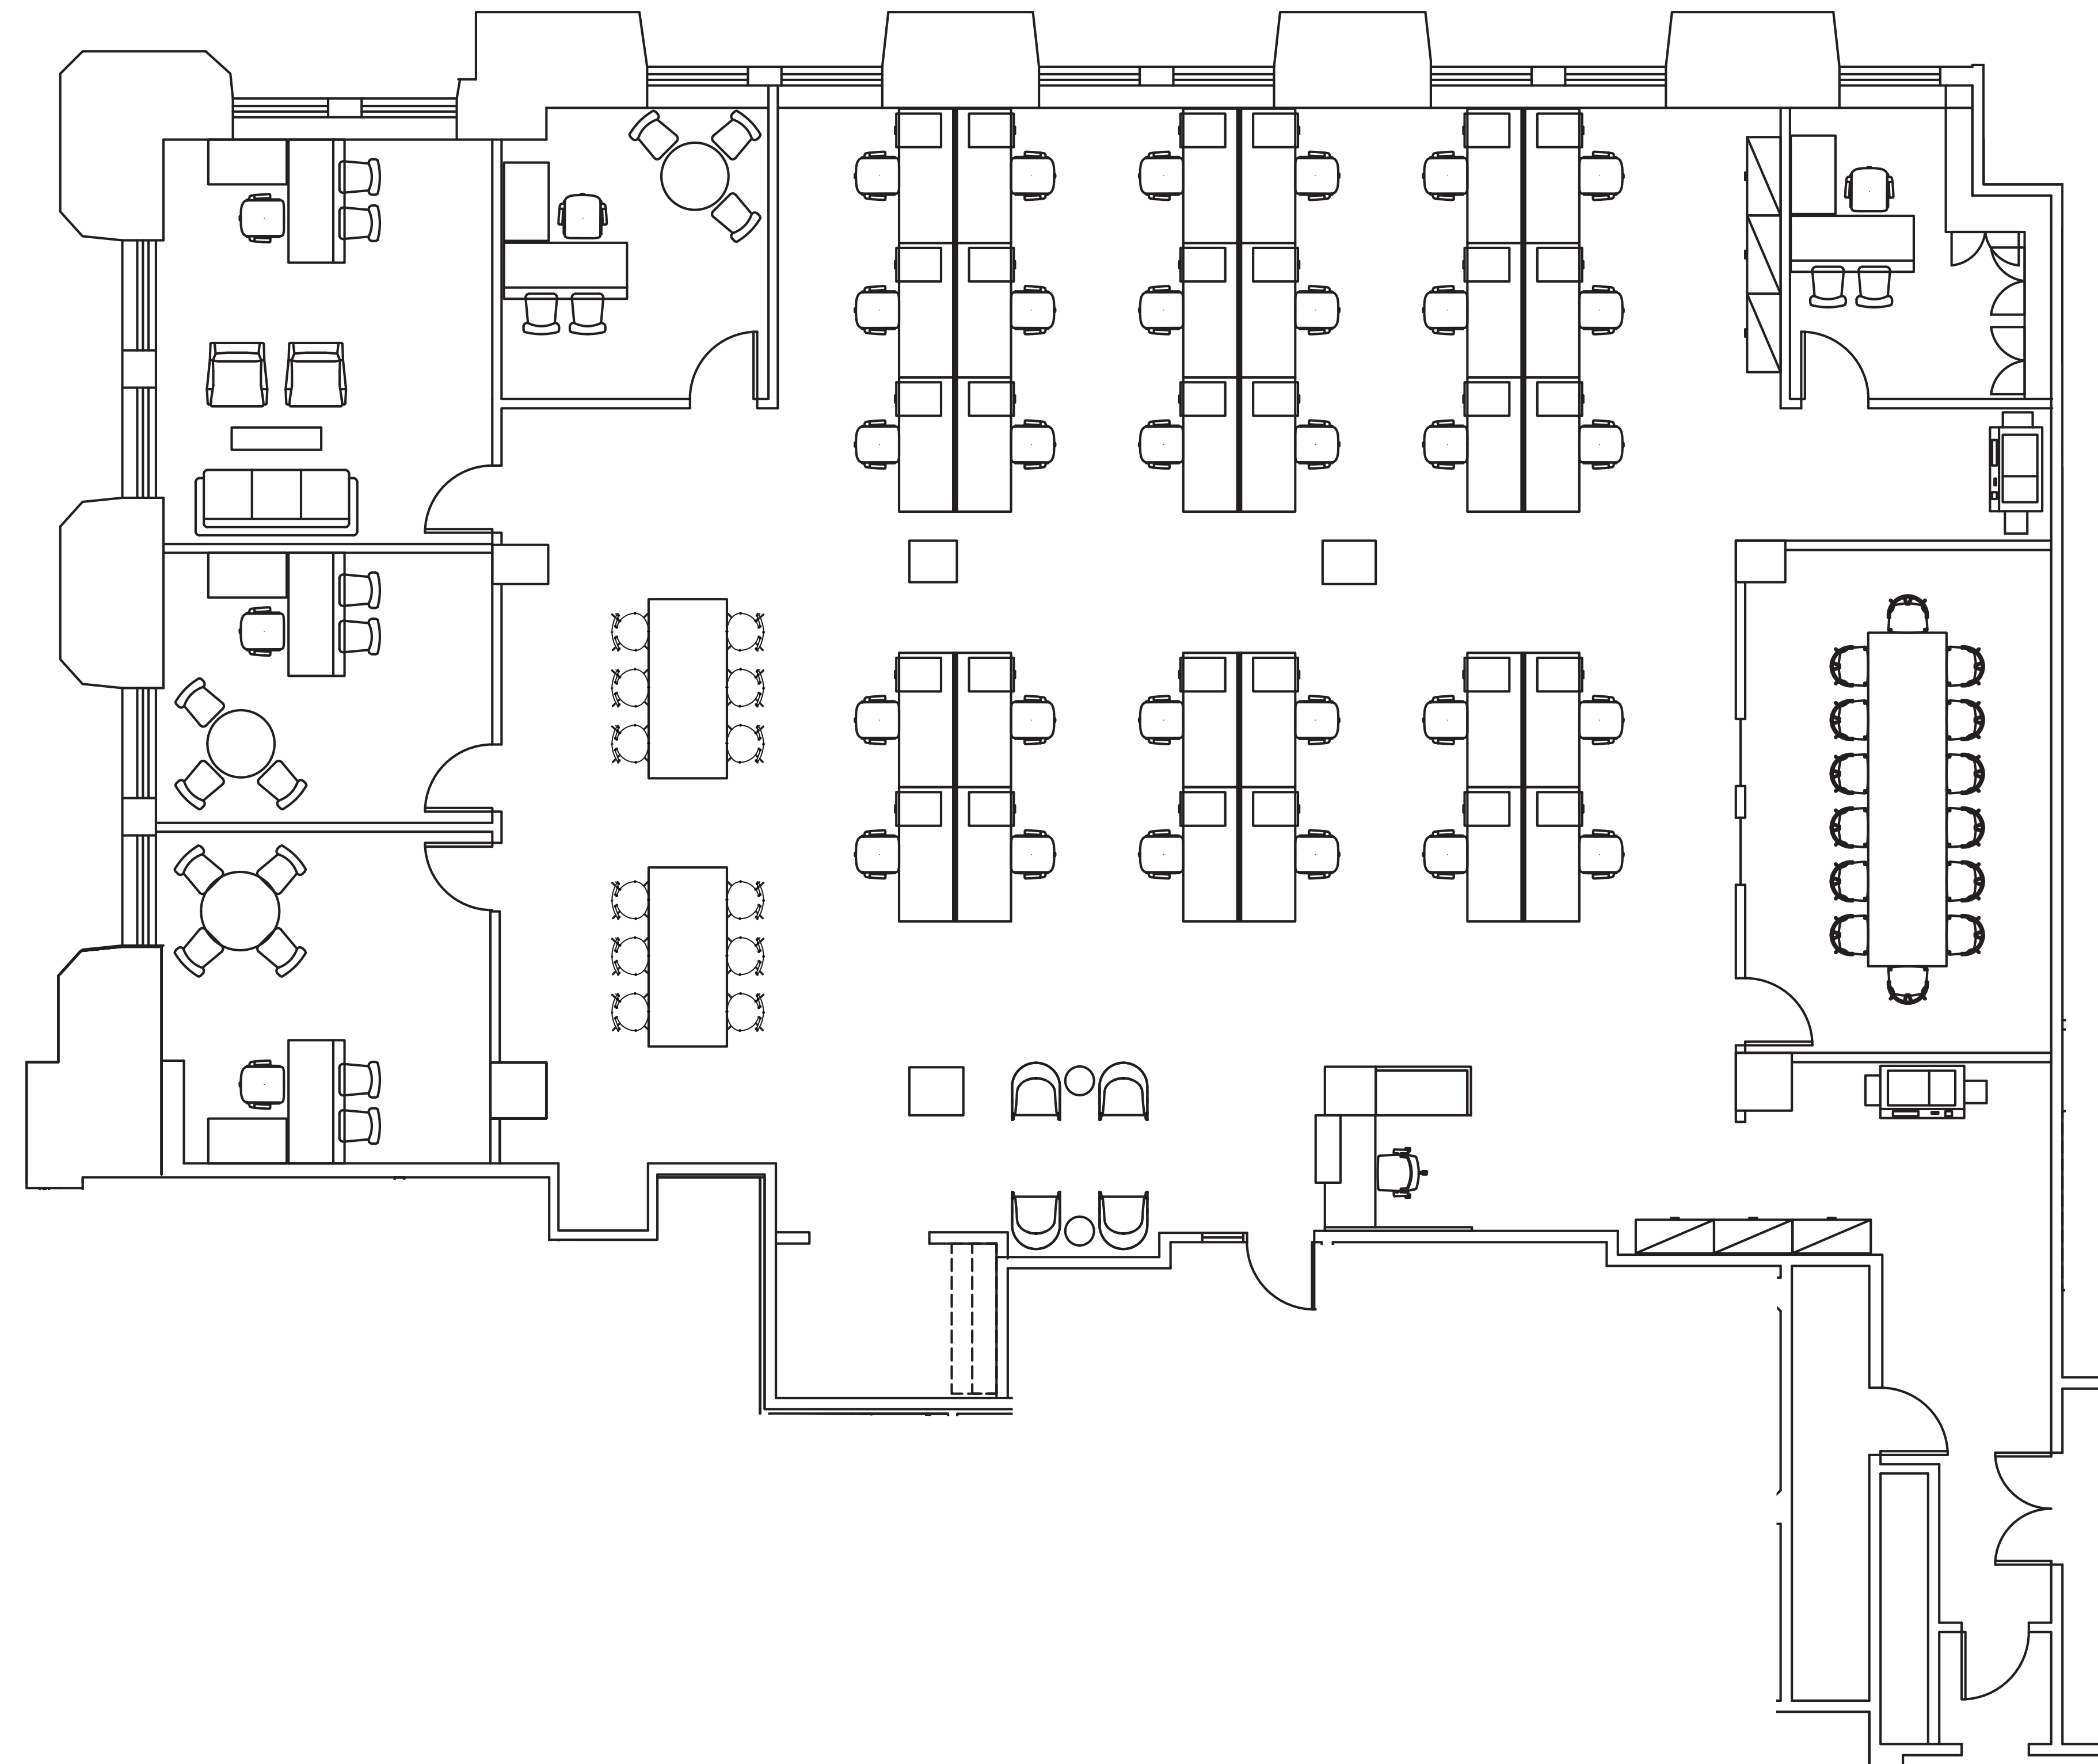

For leasing information please contact:
Andrew D. Tashjian
213.955.5148
andrew.tashjian@cushwake.com