

SUITE: 435

RSF: 6,136

ONNI TIMES SQUARE


EST. 1935

AS-BUILT CONFIGURATION

OFFICES.....	9
RECEPTION.....	1
CONFERENCE ROOMS.....	2
KITCHEN.....	1
OPEN WORK AREA.....	+/- 17

Not to scale, furniture and appliances not included

KEY PLAN

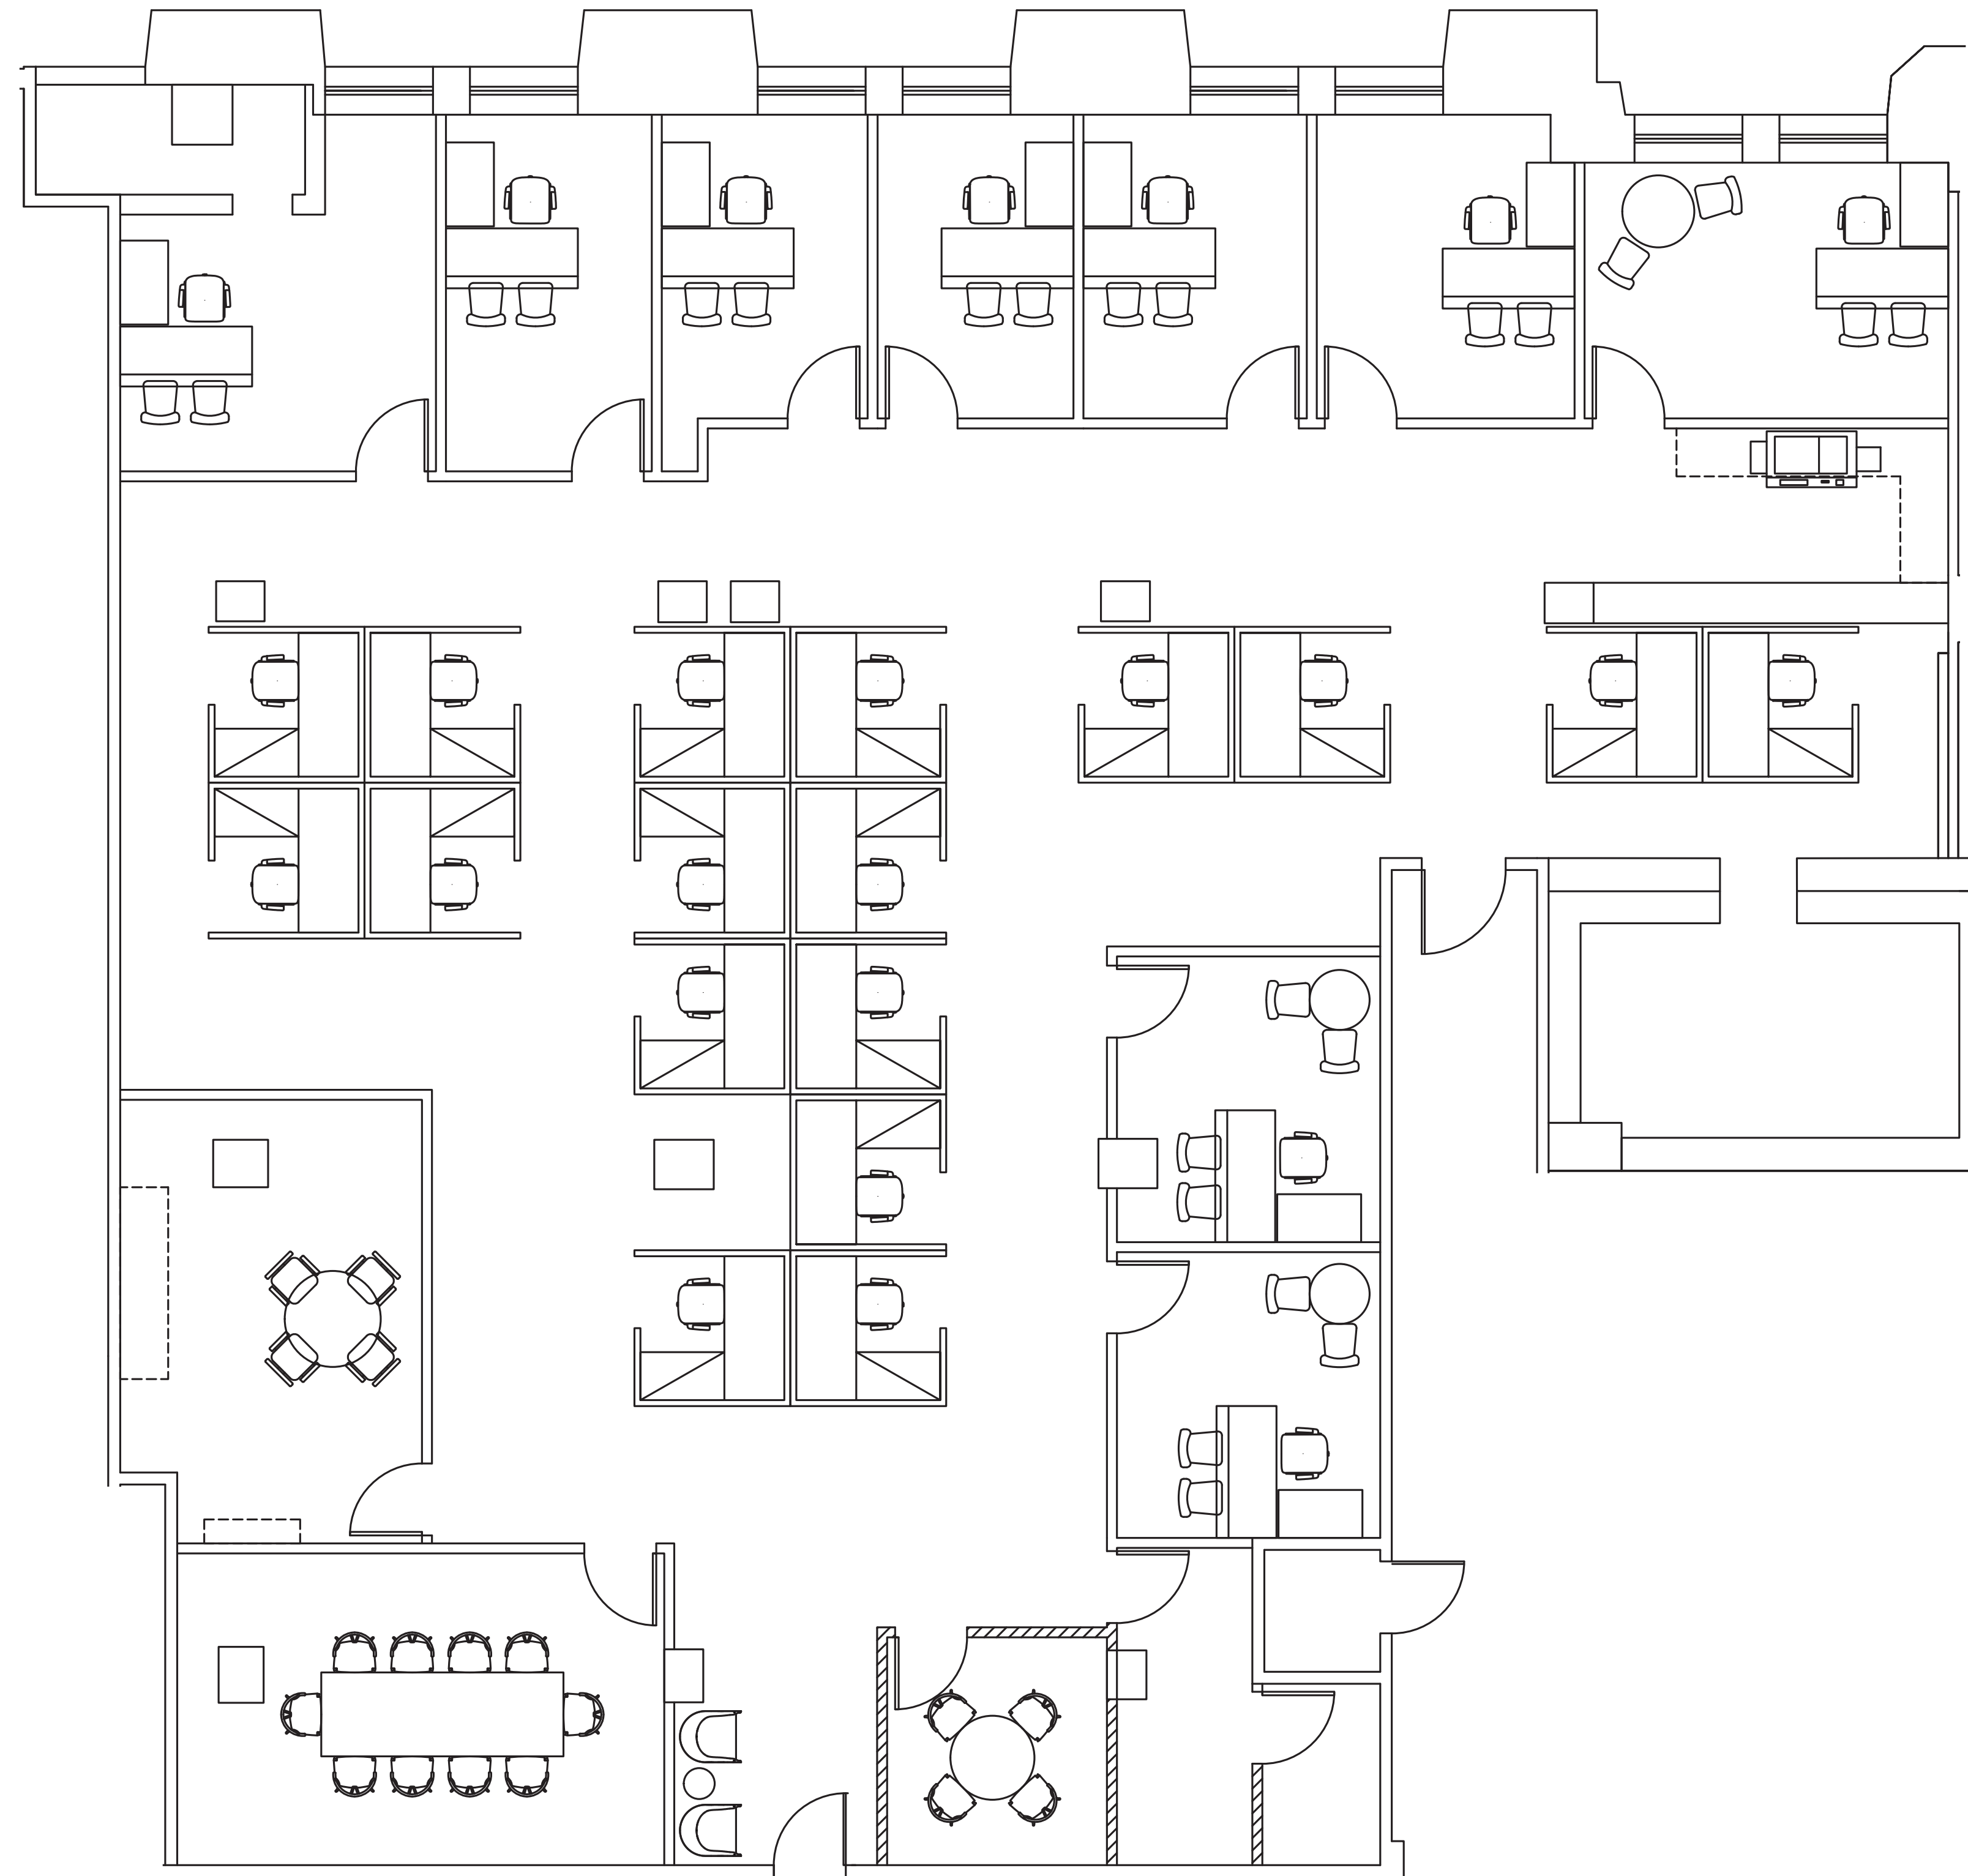

For leasing information please contact:
Andrew D. Tashjian
213.955.5148
andrew.tashjian@cushwake.com

