

SUITE: 300

RSF: 28,597

ONNI TIMES SQUARE



EST. 1935

AS-BUILT CONFIGURATION

- OFFICES..... TBD
- RECEPTION..... TBD
- CONFERENCE ROOMS..... TBD
- KITCHEN..... TBD
- OPEN WORK AREA..... TBD

Not to scale, furniture and appliances not included

KEY PLAN

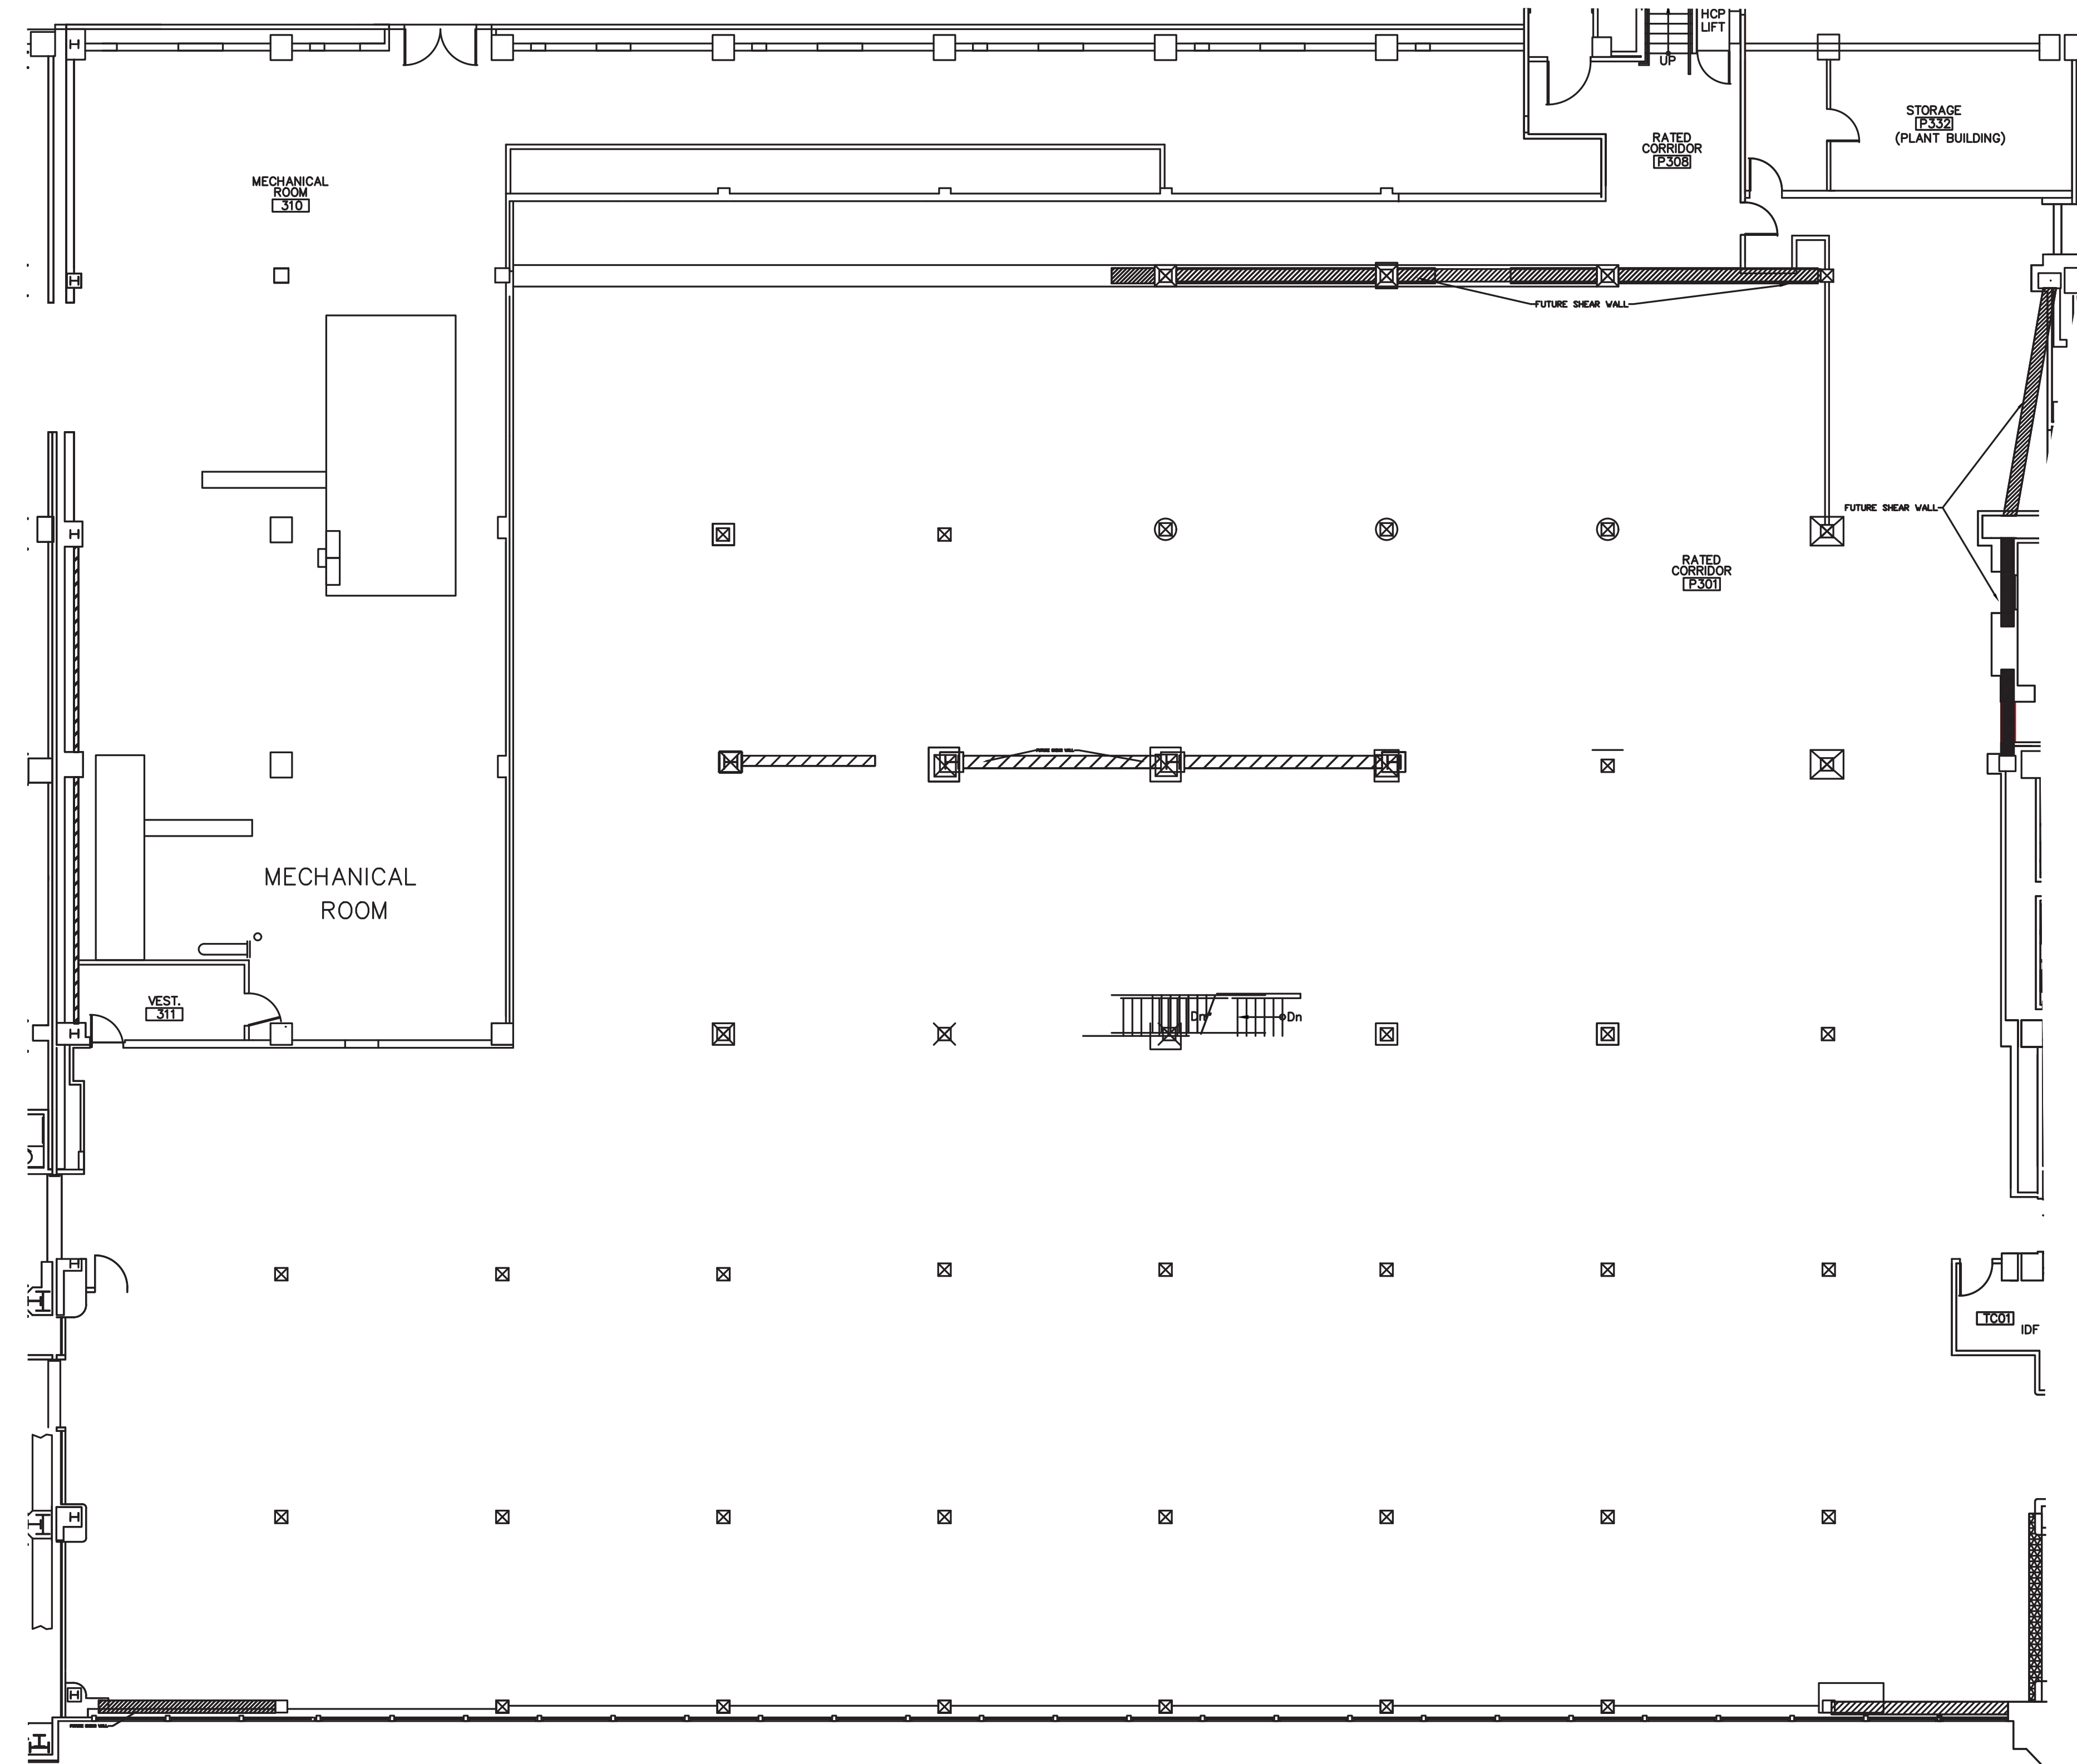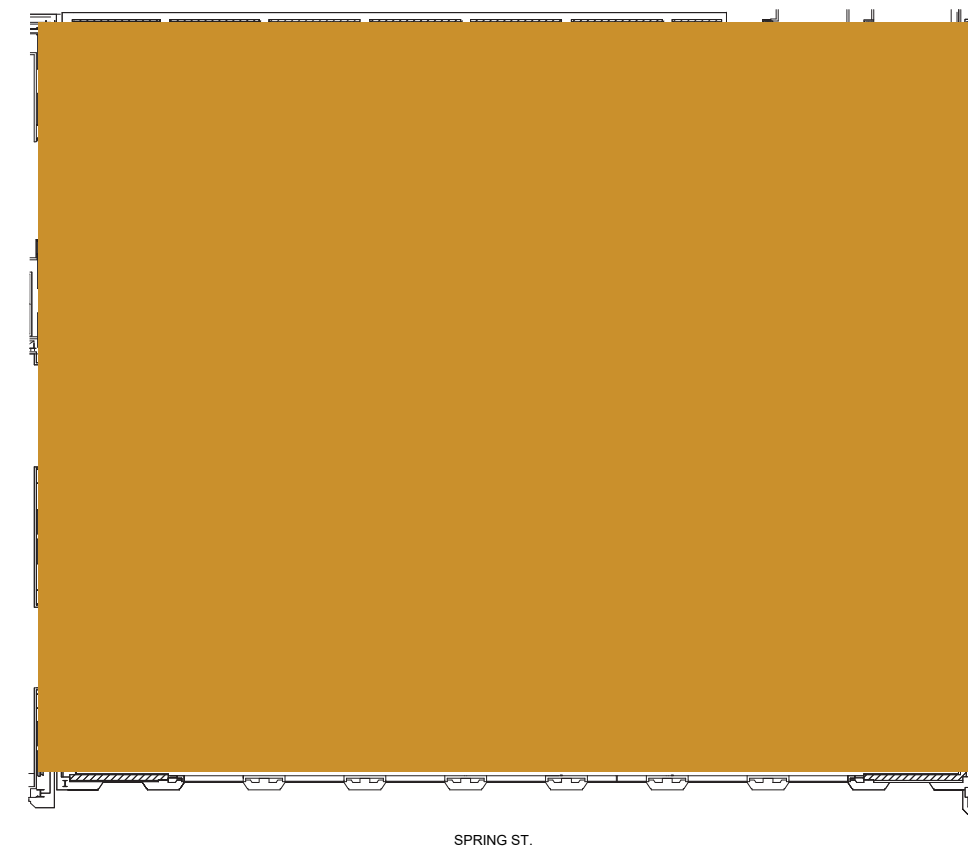

For leasing information please contact:
Andrew D. Tashjian
213.955.5148
andrew.tashjian@cushwake.com

