

AS-BUILT CONFIGURATION

OFFICES..... TBD

RECEPTION..... TBD



CONFERENCE ROOMS..... TBD

KITCHEN..... TBD

OPEN WORK AREA..... TBD

Not to scale, furniture and appliances not included

KEY PLAN

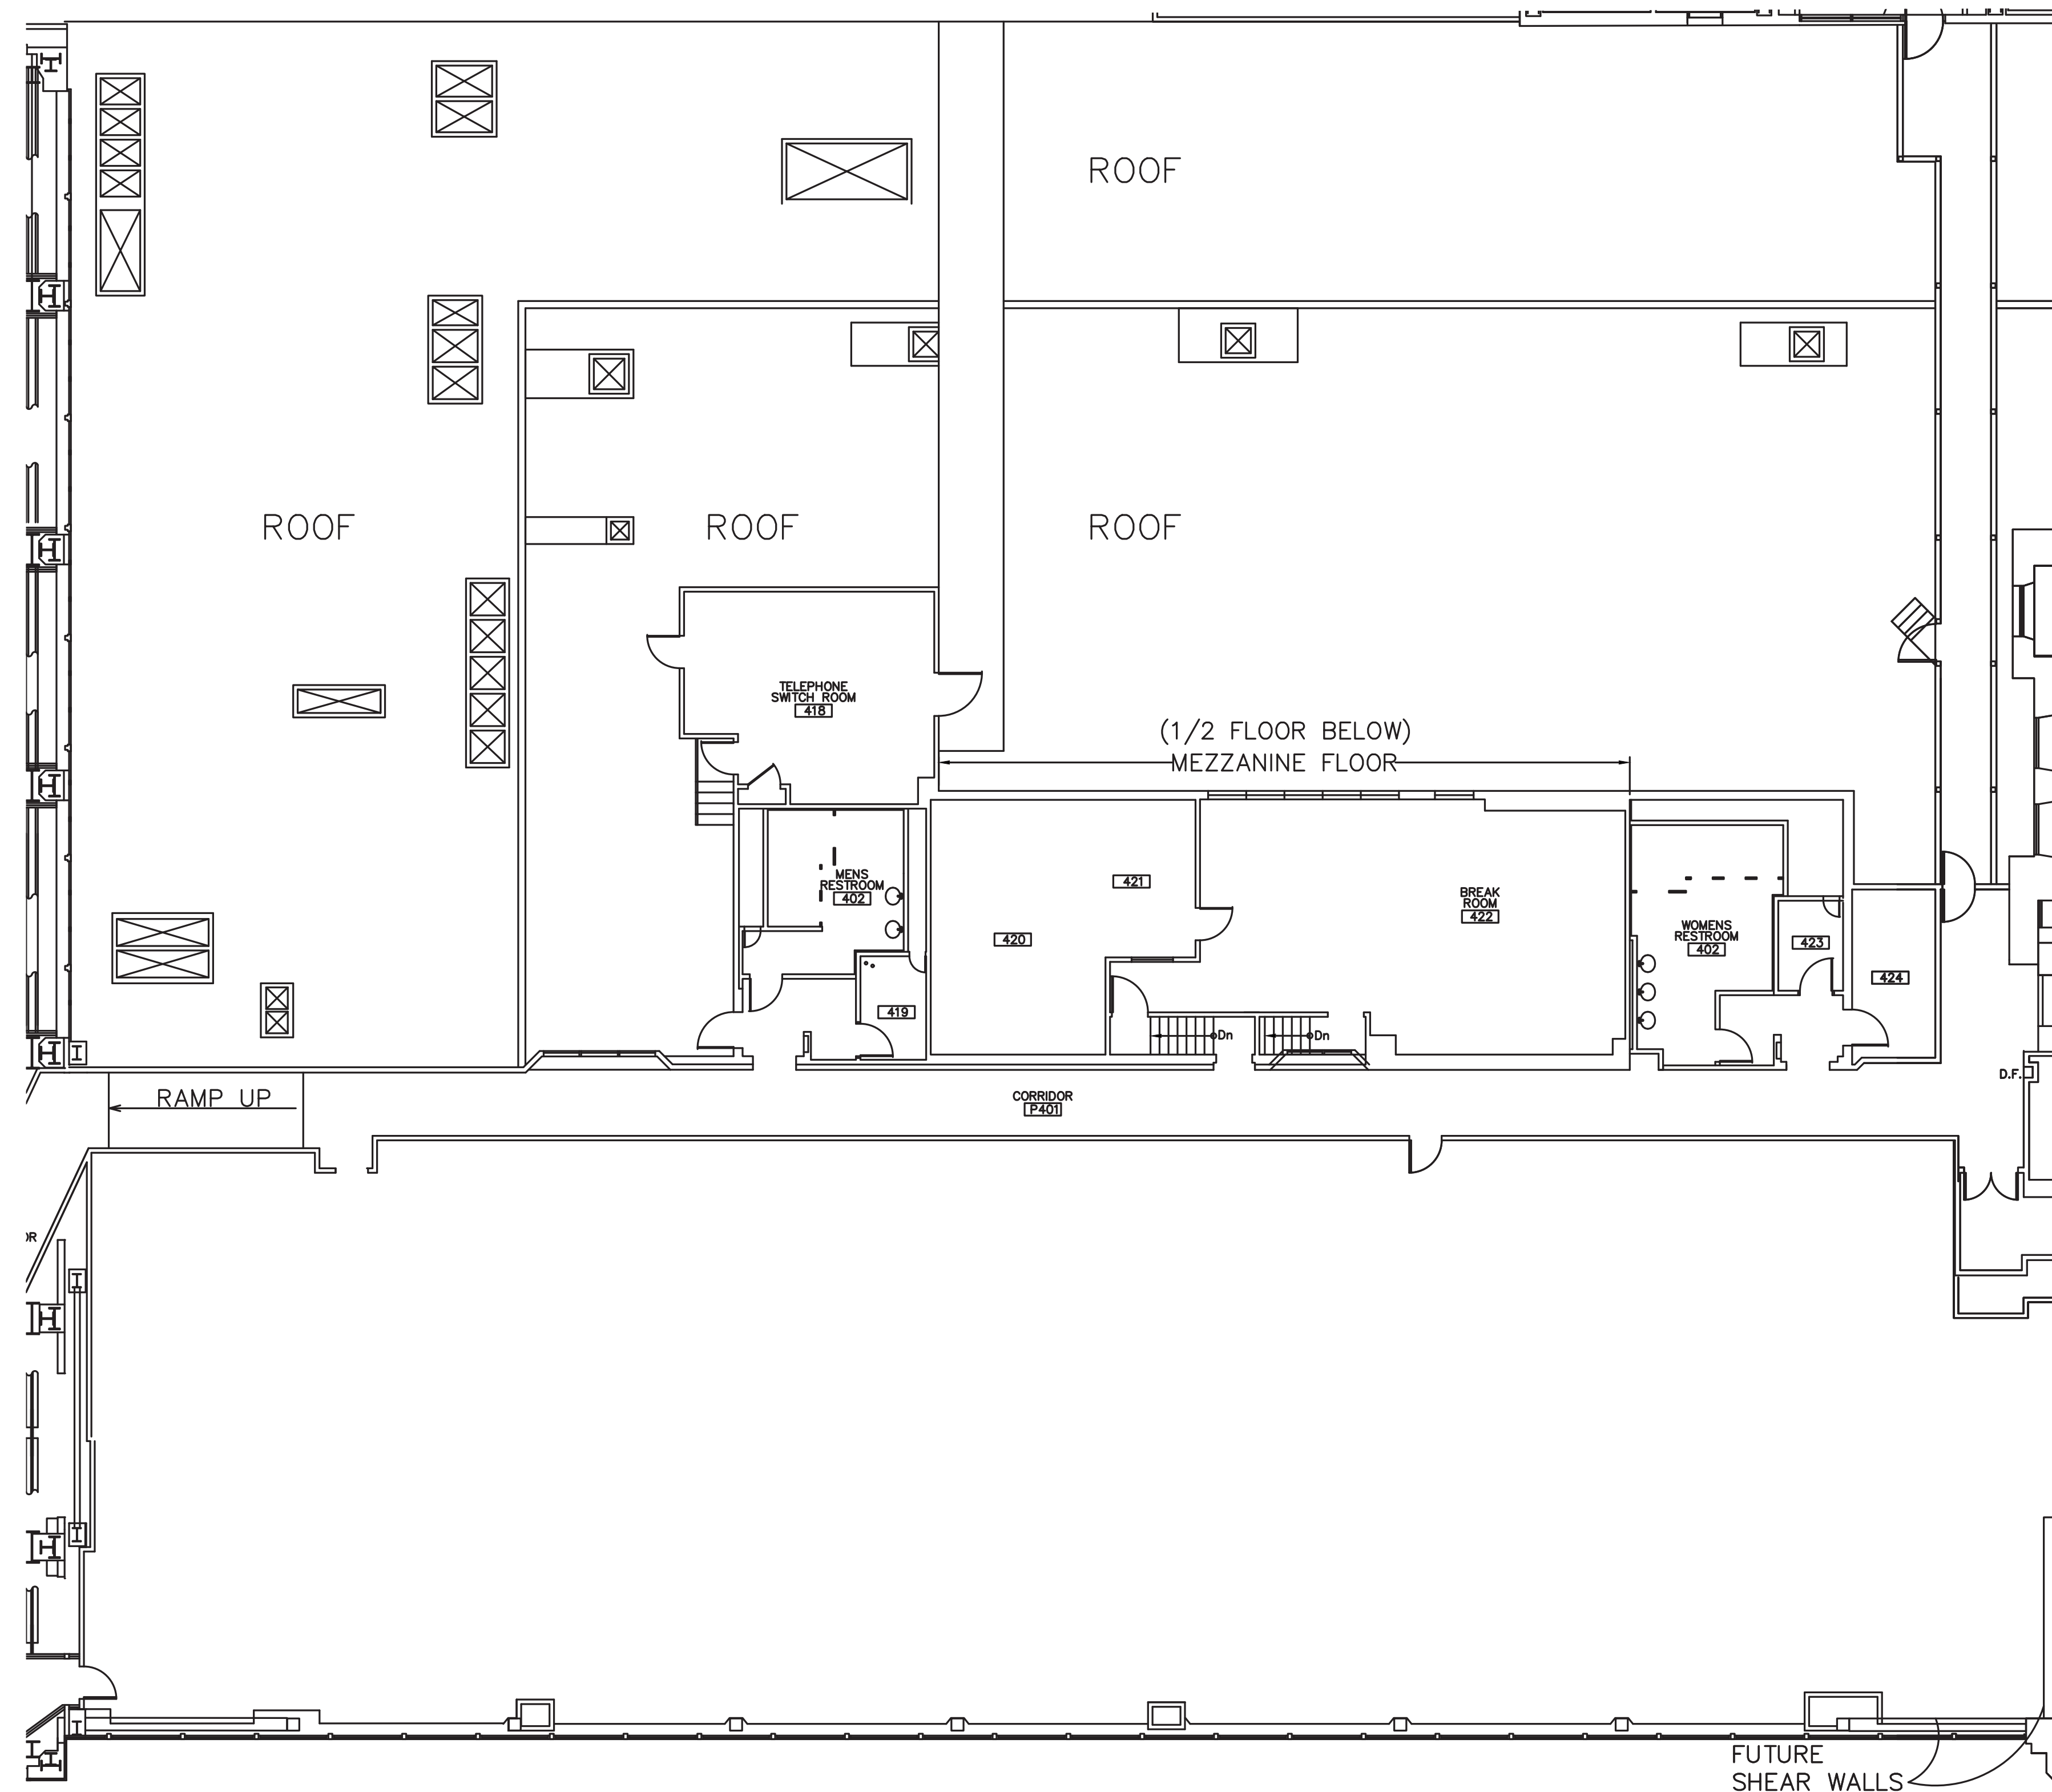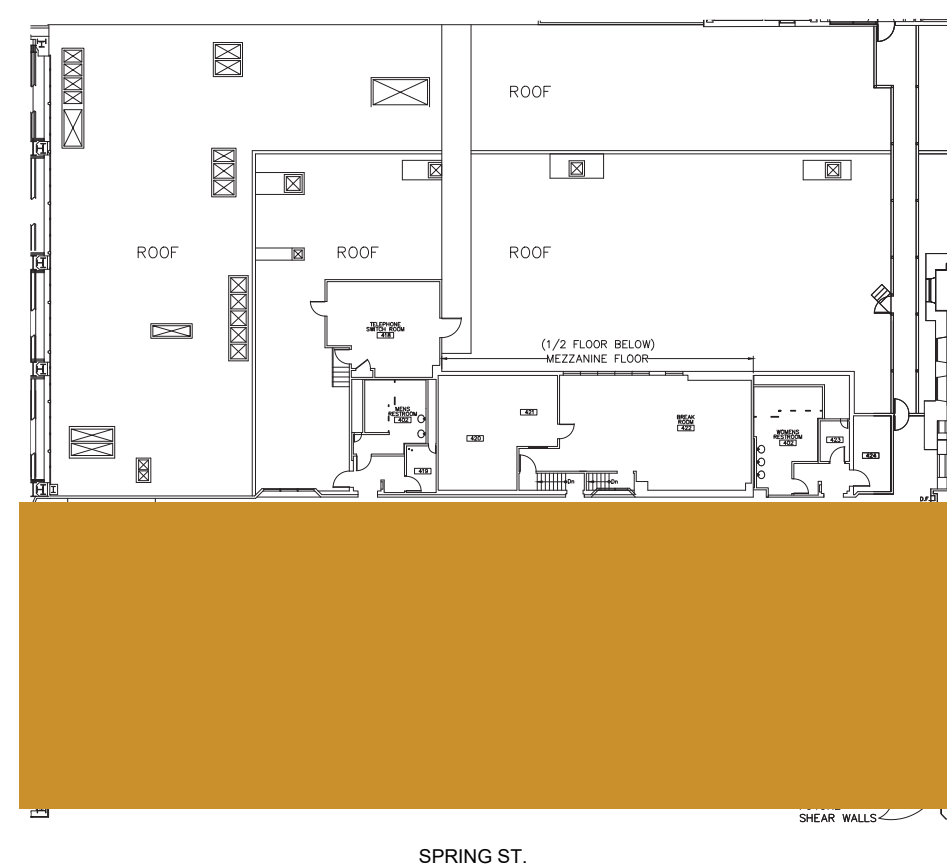

For leasing information please contact:
Andrew D. Tashjian
213.955.5148
andrew.tashjian@cushwake.com