
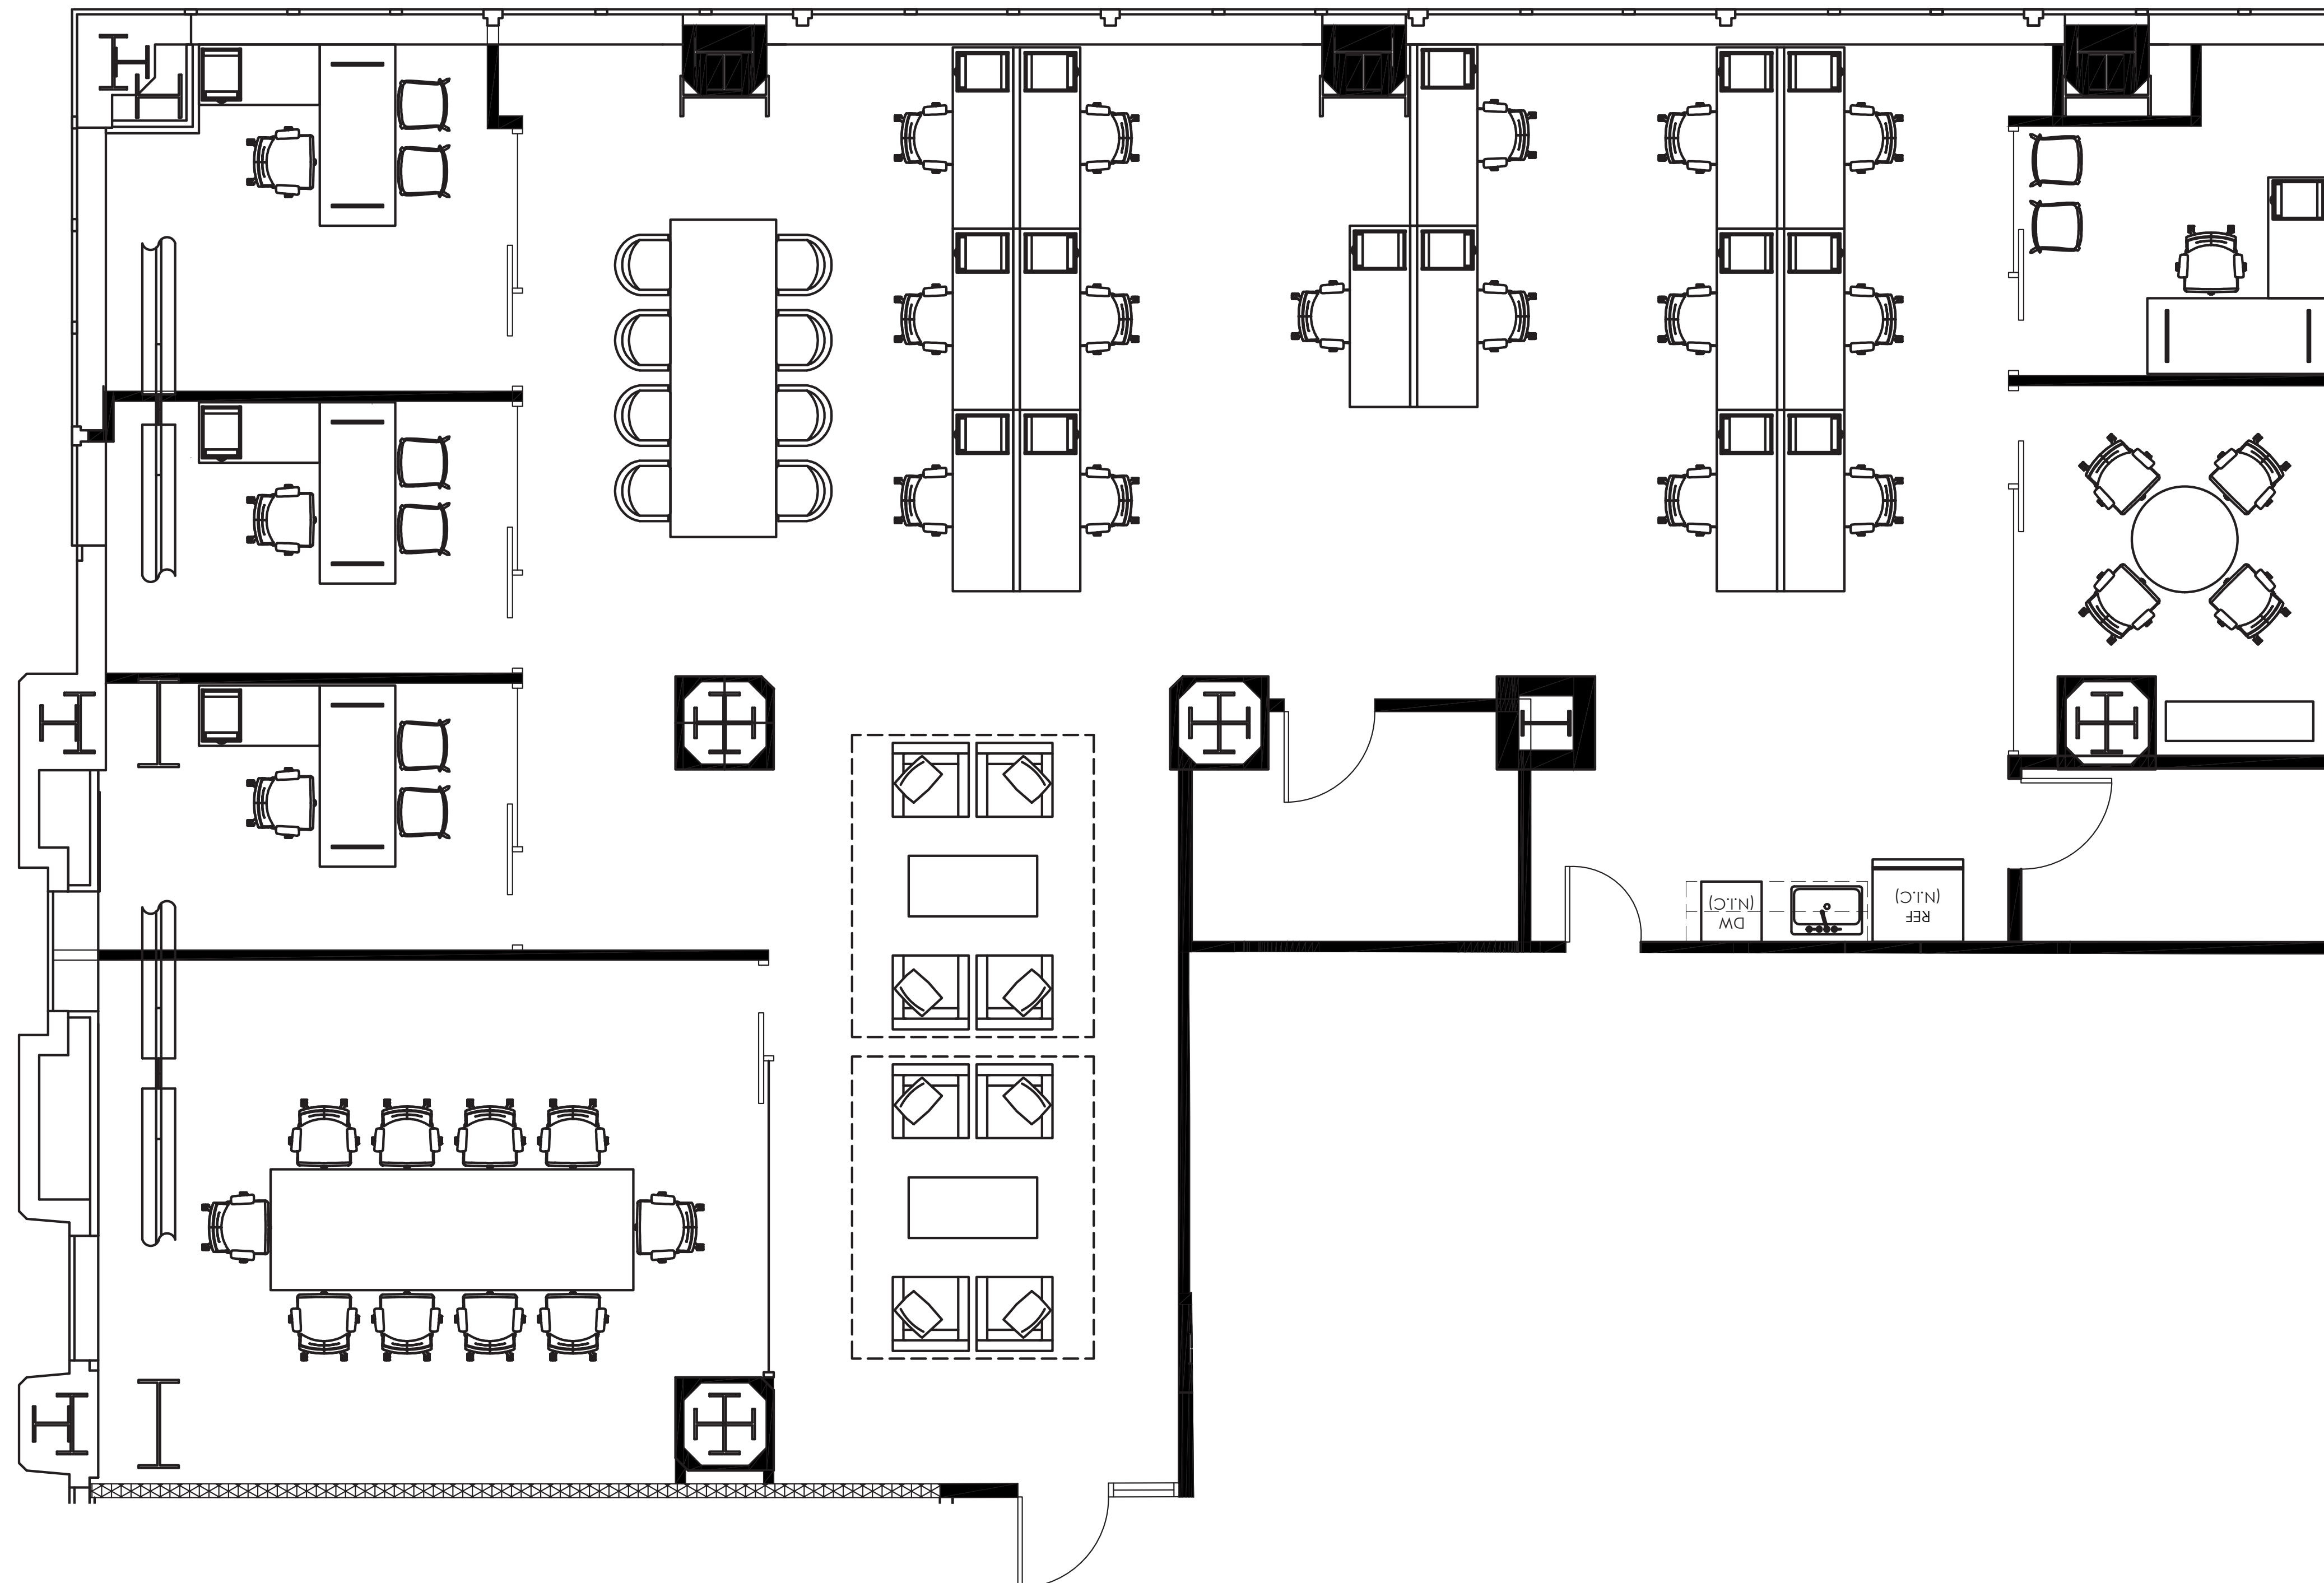


AS-BUILT CONFIGURATION

PRIVATE OFFICES.....	4
CONFERENCE ROOMS.....	2
KITCHEN.....	1
OPEN WORK AREA.....	+/-15

Not to scale, furniture and appliances not included

KEY PLAN

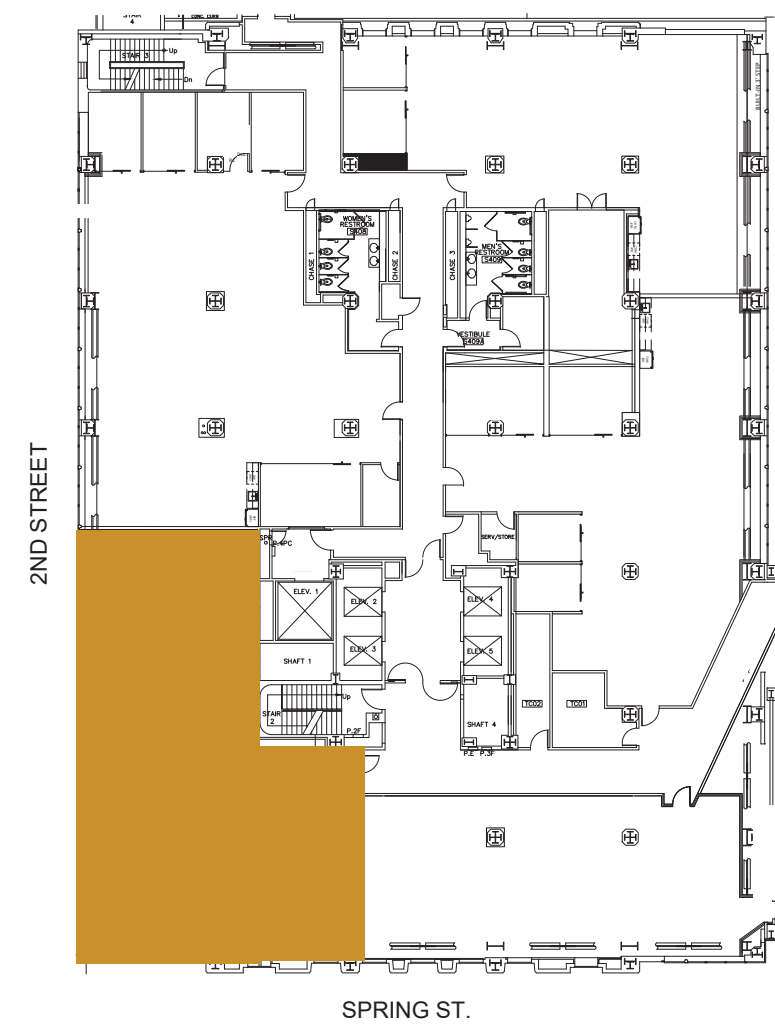

For leasing information please contact:

USALEASING@ONNI.COM
 (213) 629-2041