

# SUITE: 430

# RSF: 3,064

# ONNI TIMES SQUARE



EST. 1935

## AS-BUILT CONFIGURATION

OFFICES.....	2
RECEPTION.....	1
CONFERENCE ROOMS.....	0
KITCHEN.....	1
OPEN WORK AREA.....	+/-22

*Not to scale, furniture and appliances not included*

## KEY PLAN

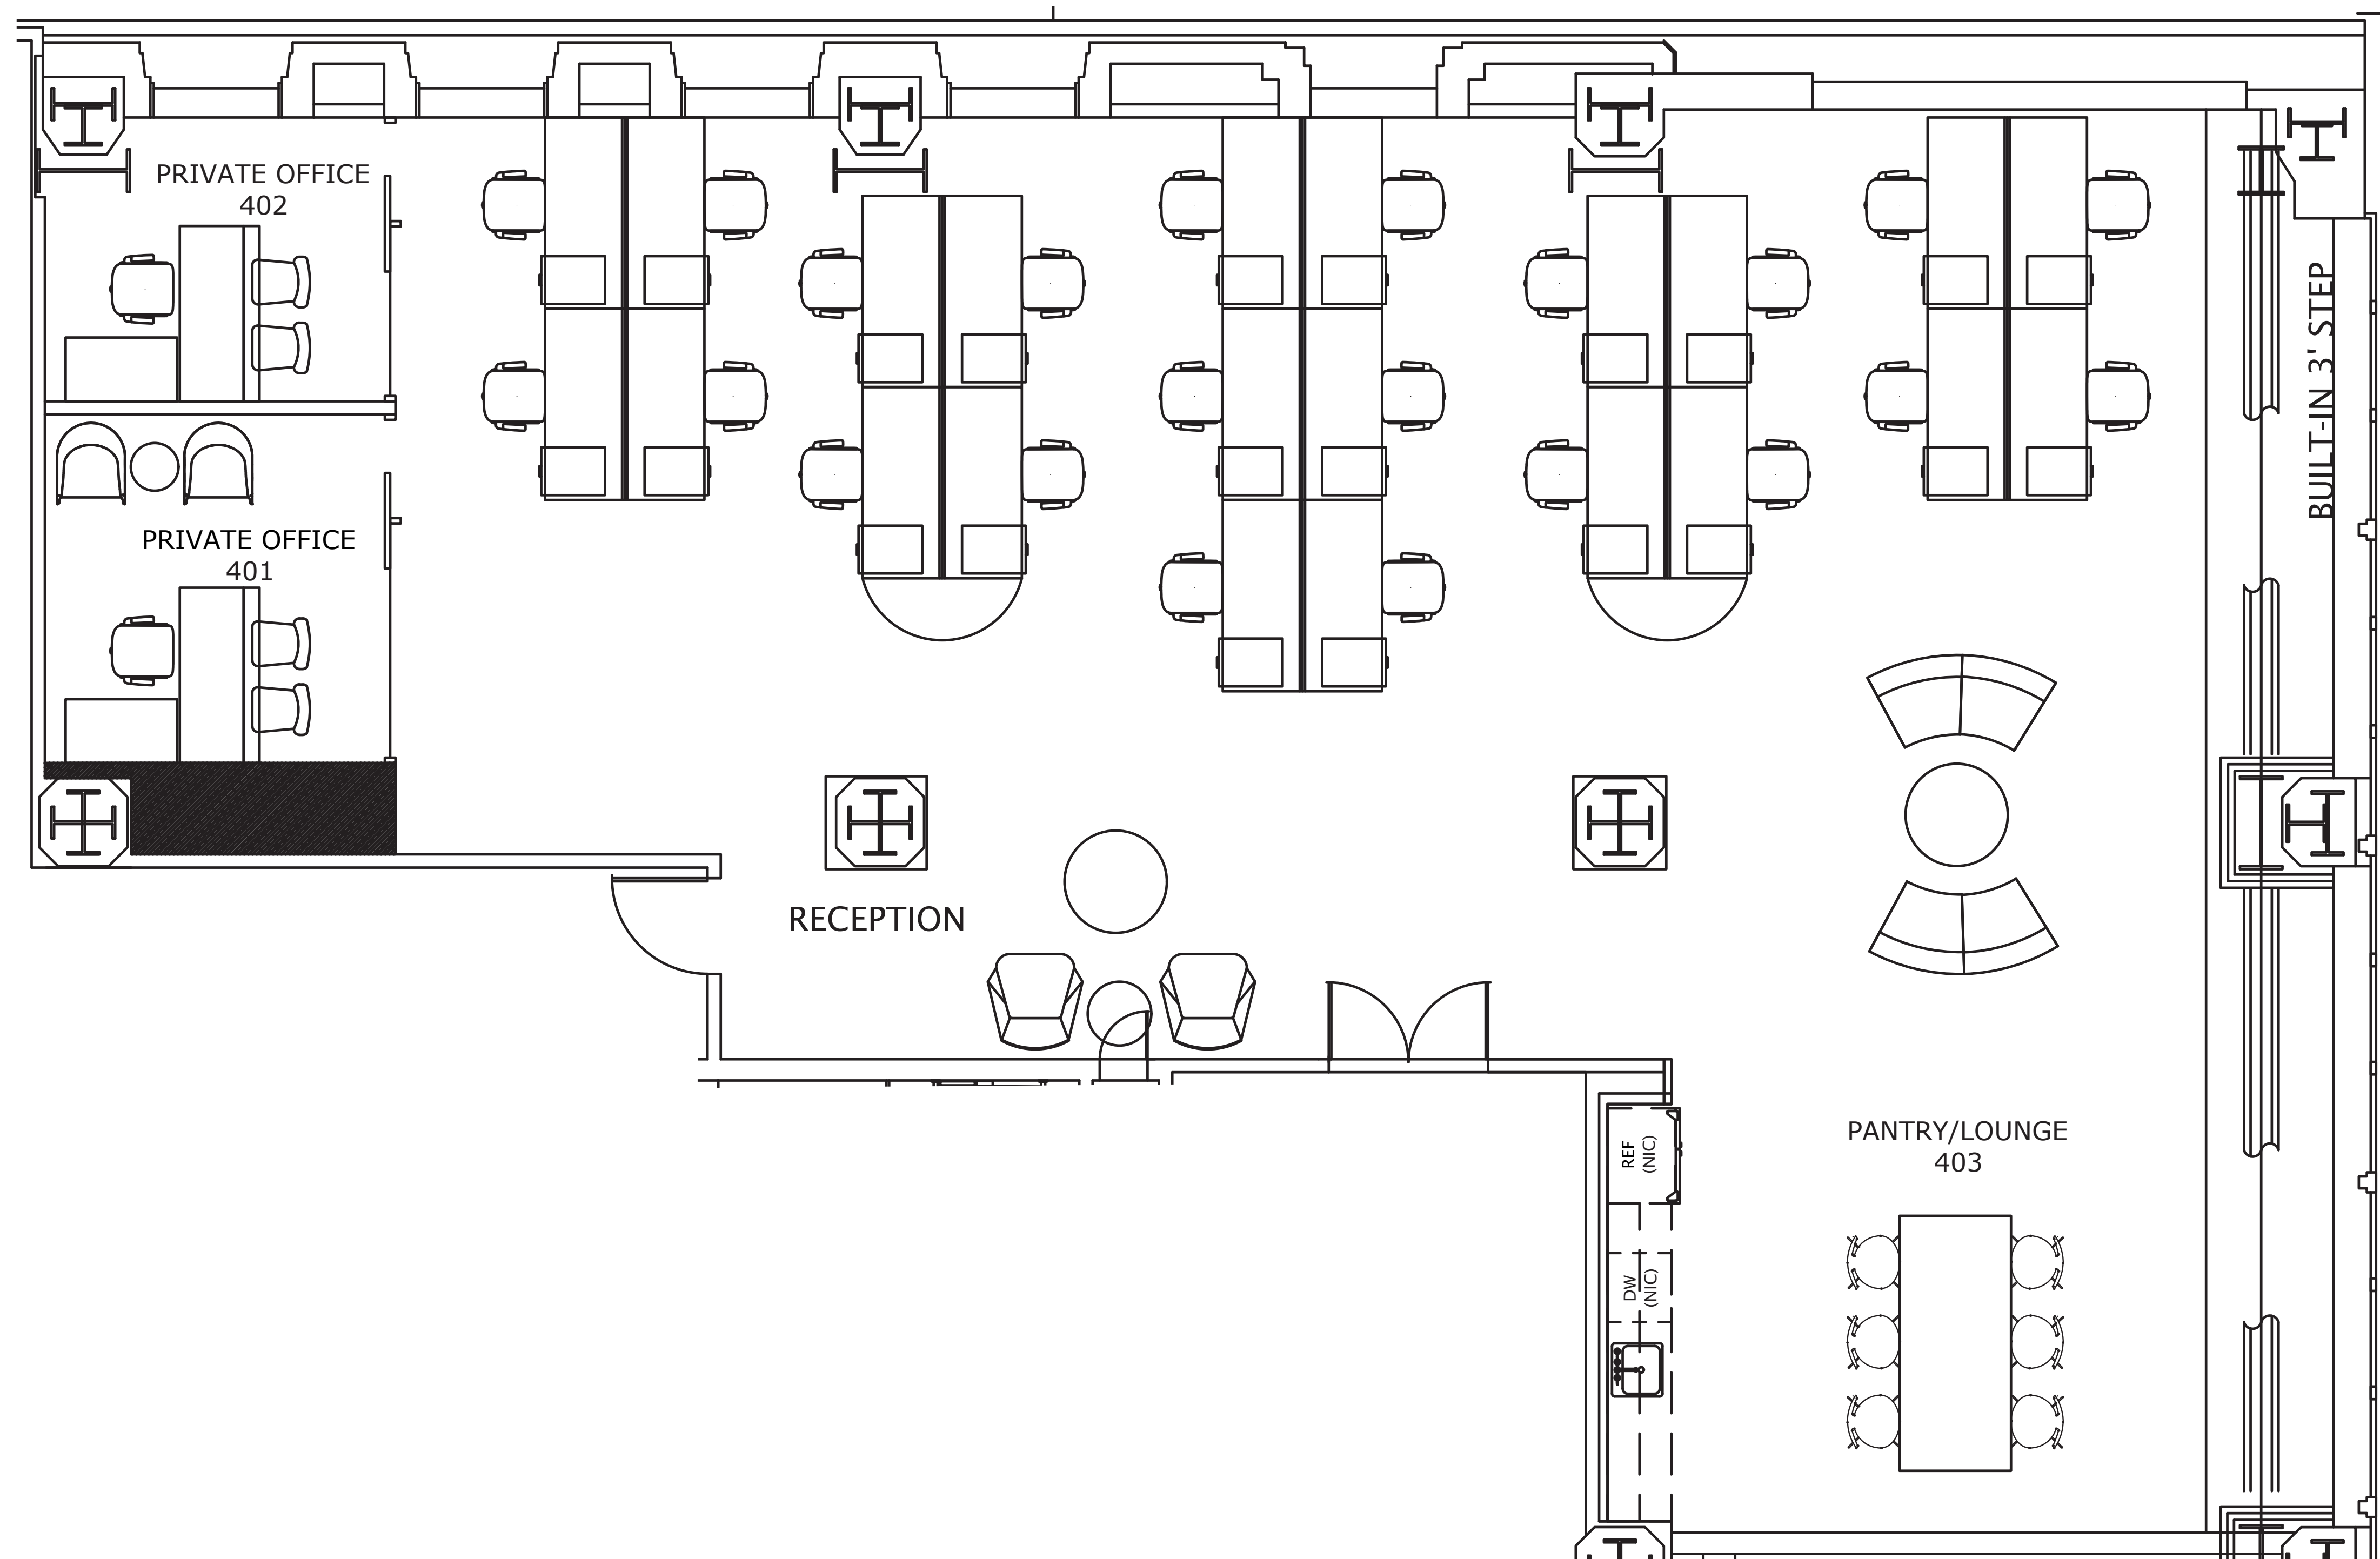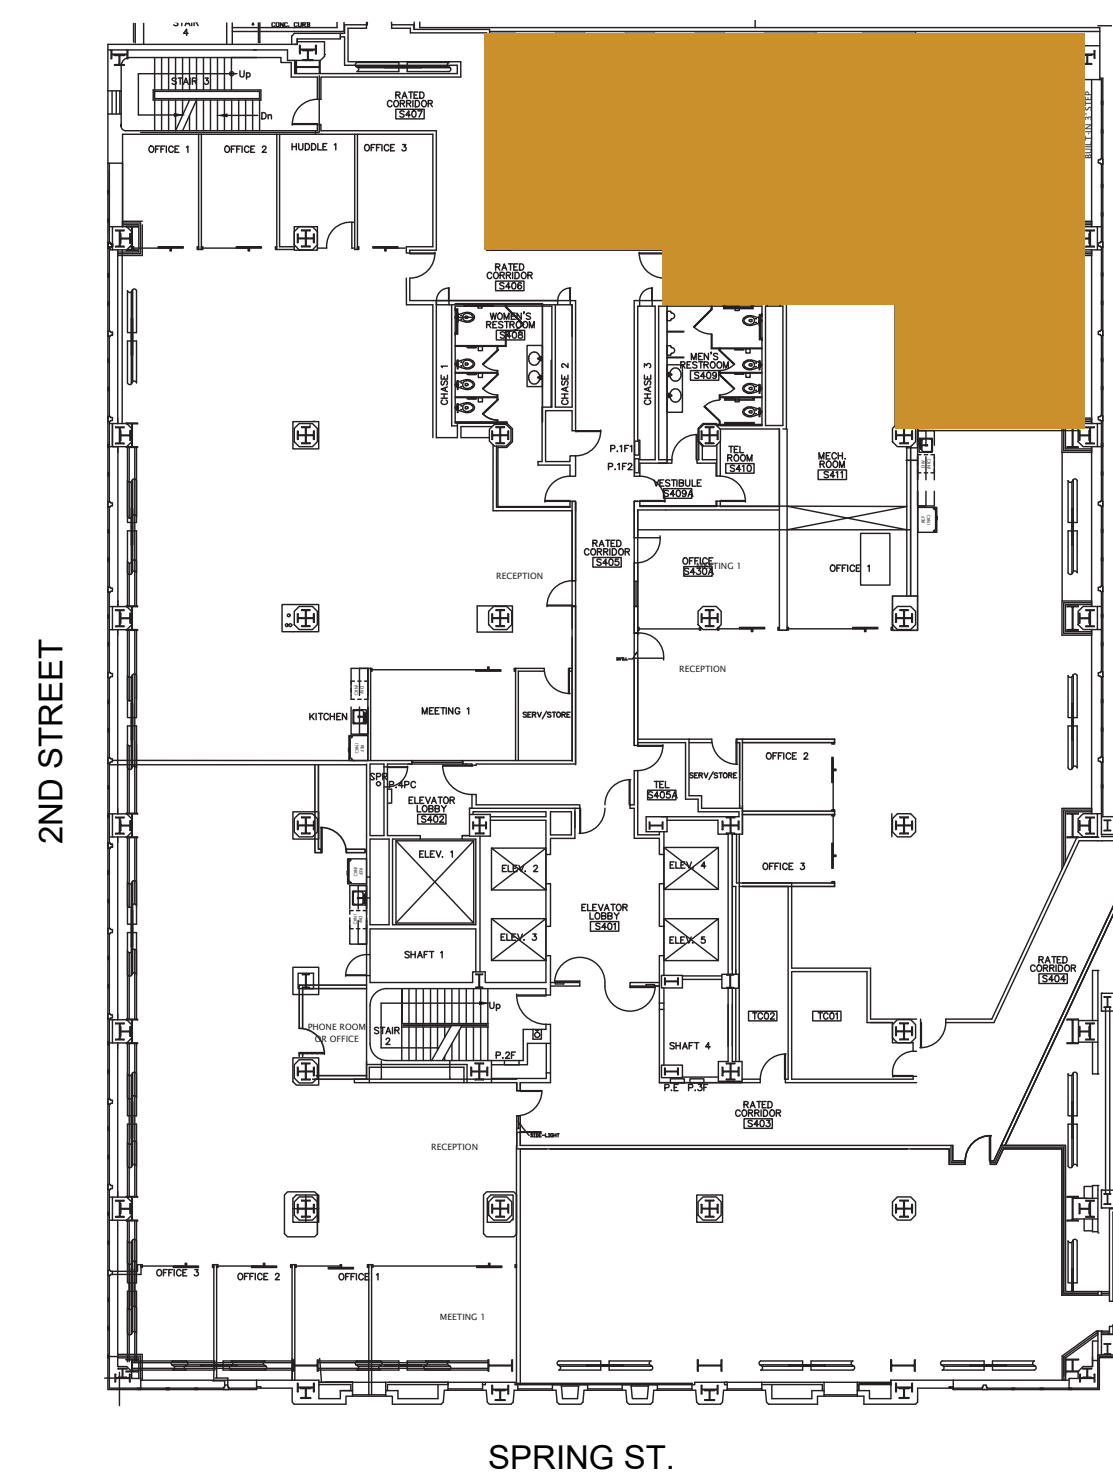

For leasing information please contact:  
Andrew D. Tashjian  
213.955.5148  
andrew.tashjian@cushwake.com

