
# SUITE: 700

### **AS-BUILT CONFIGURATION**


OFFICES	4
RECEPTION	1
CONFERENCE ROOMS	8
KITCHEN	1
OPEN WORK AREA	+/-46


Not to scale, furniture and appliances not included

#### KEY PLAN

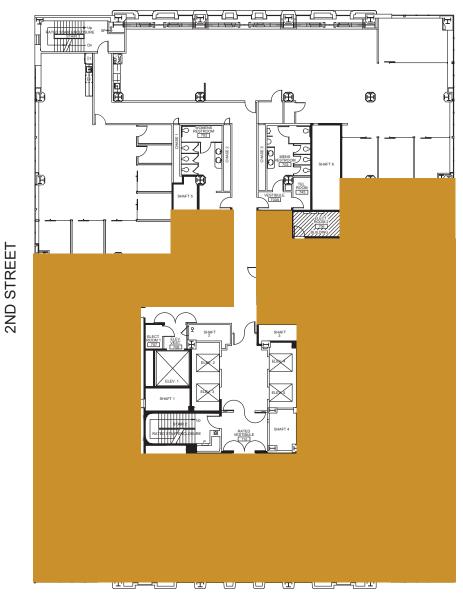

SPRING ST.

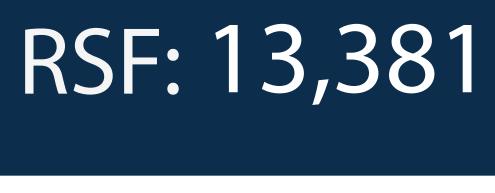

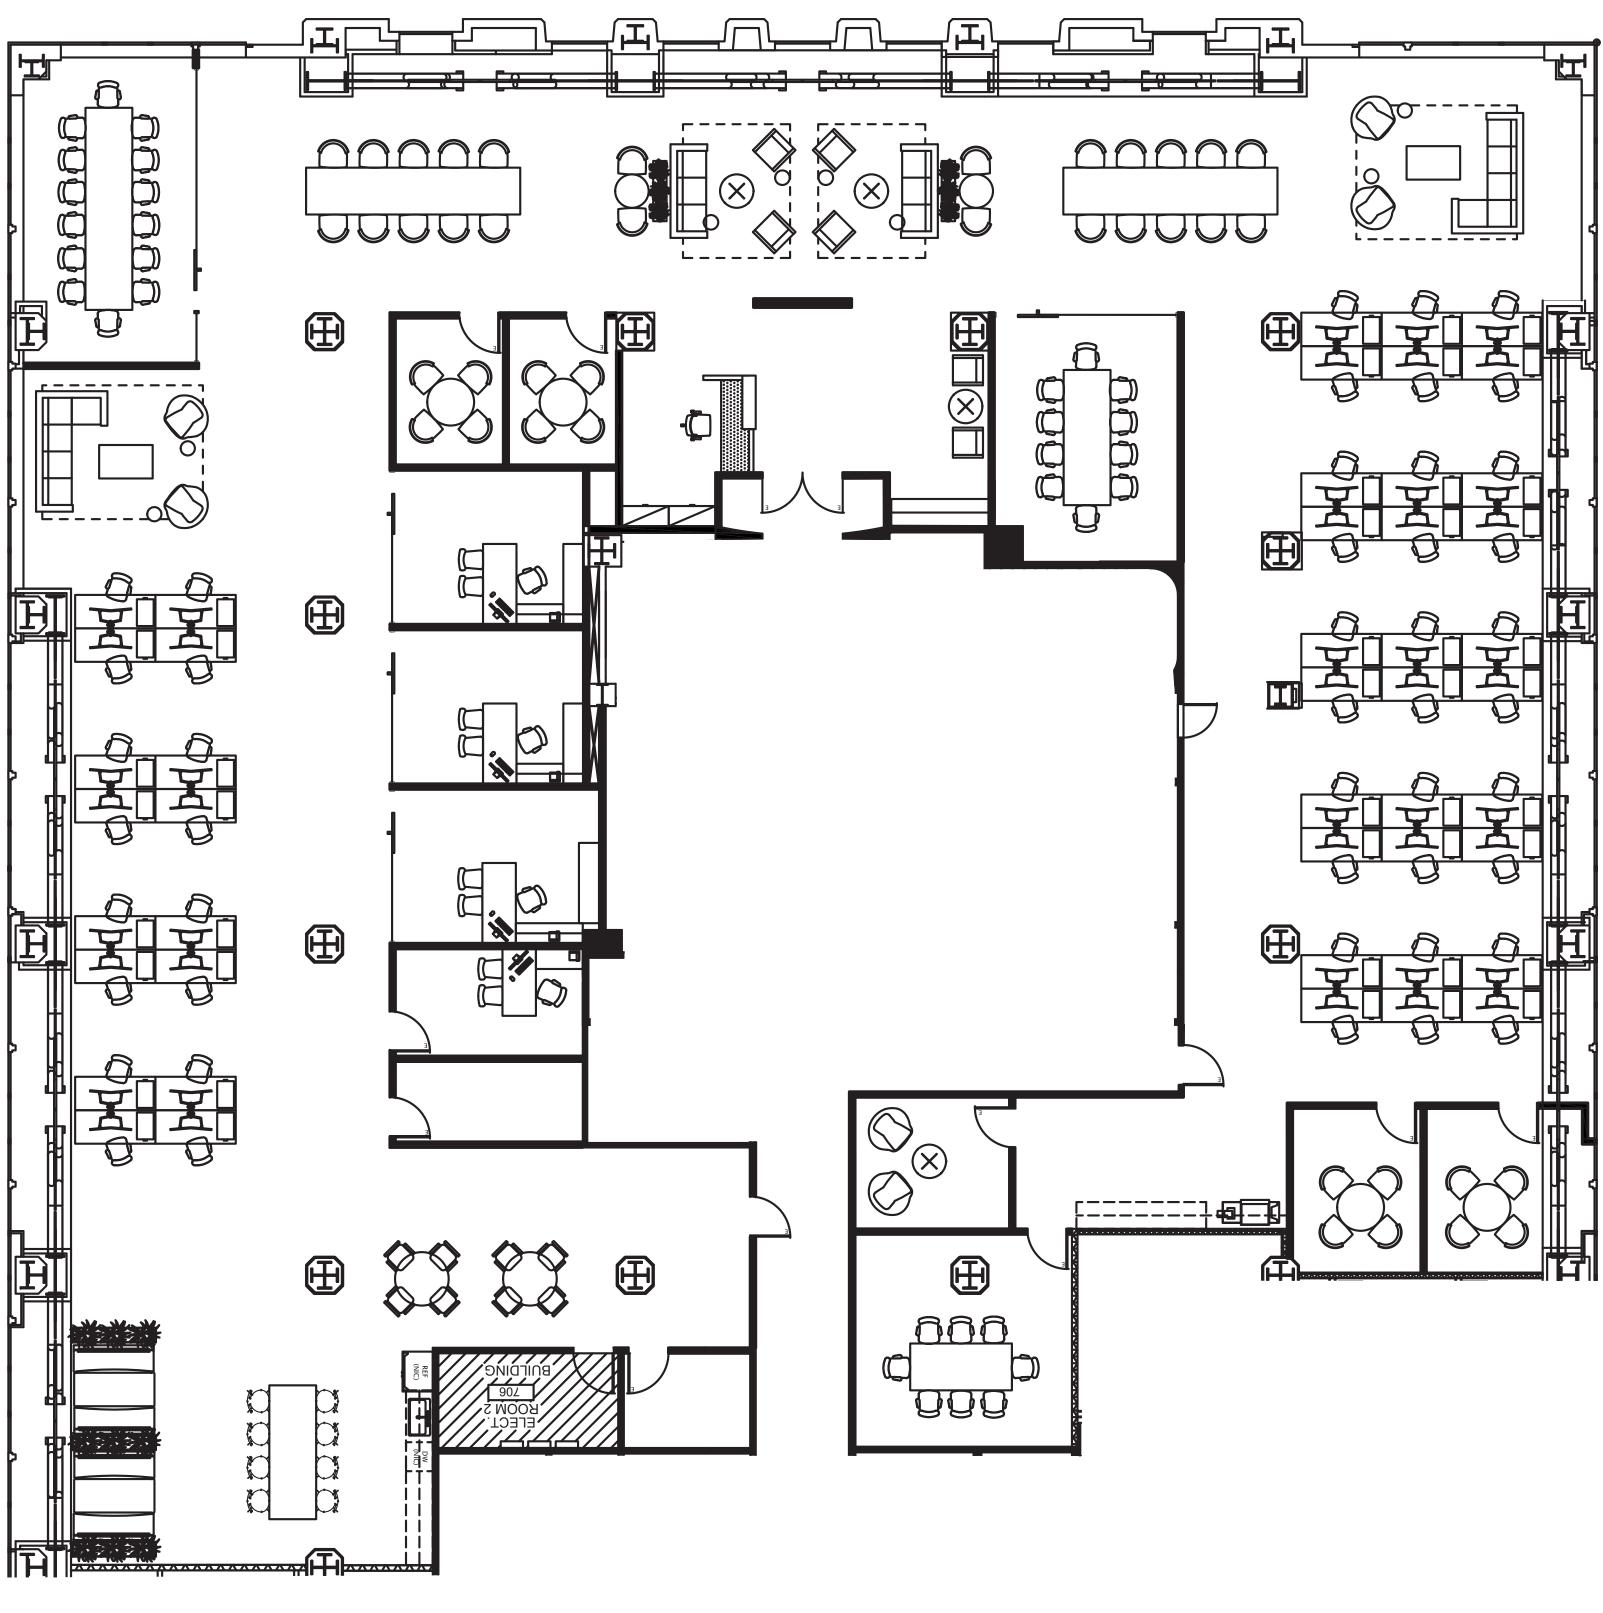

## **ONNI TIMES SQUARE** EST. 1935

