
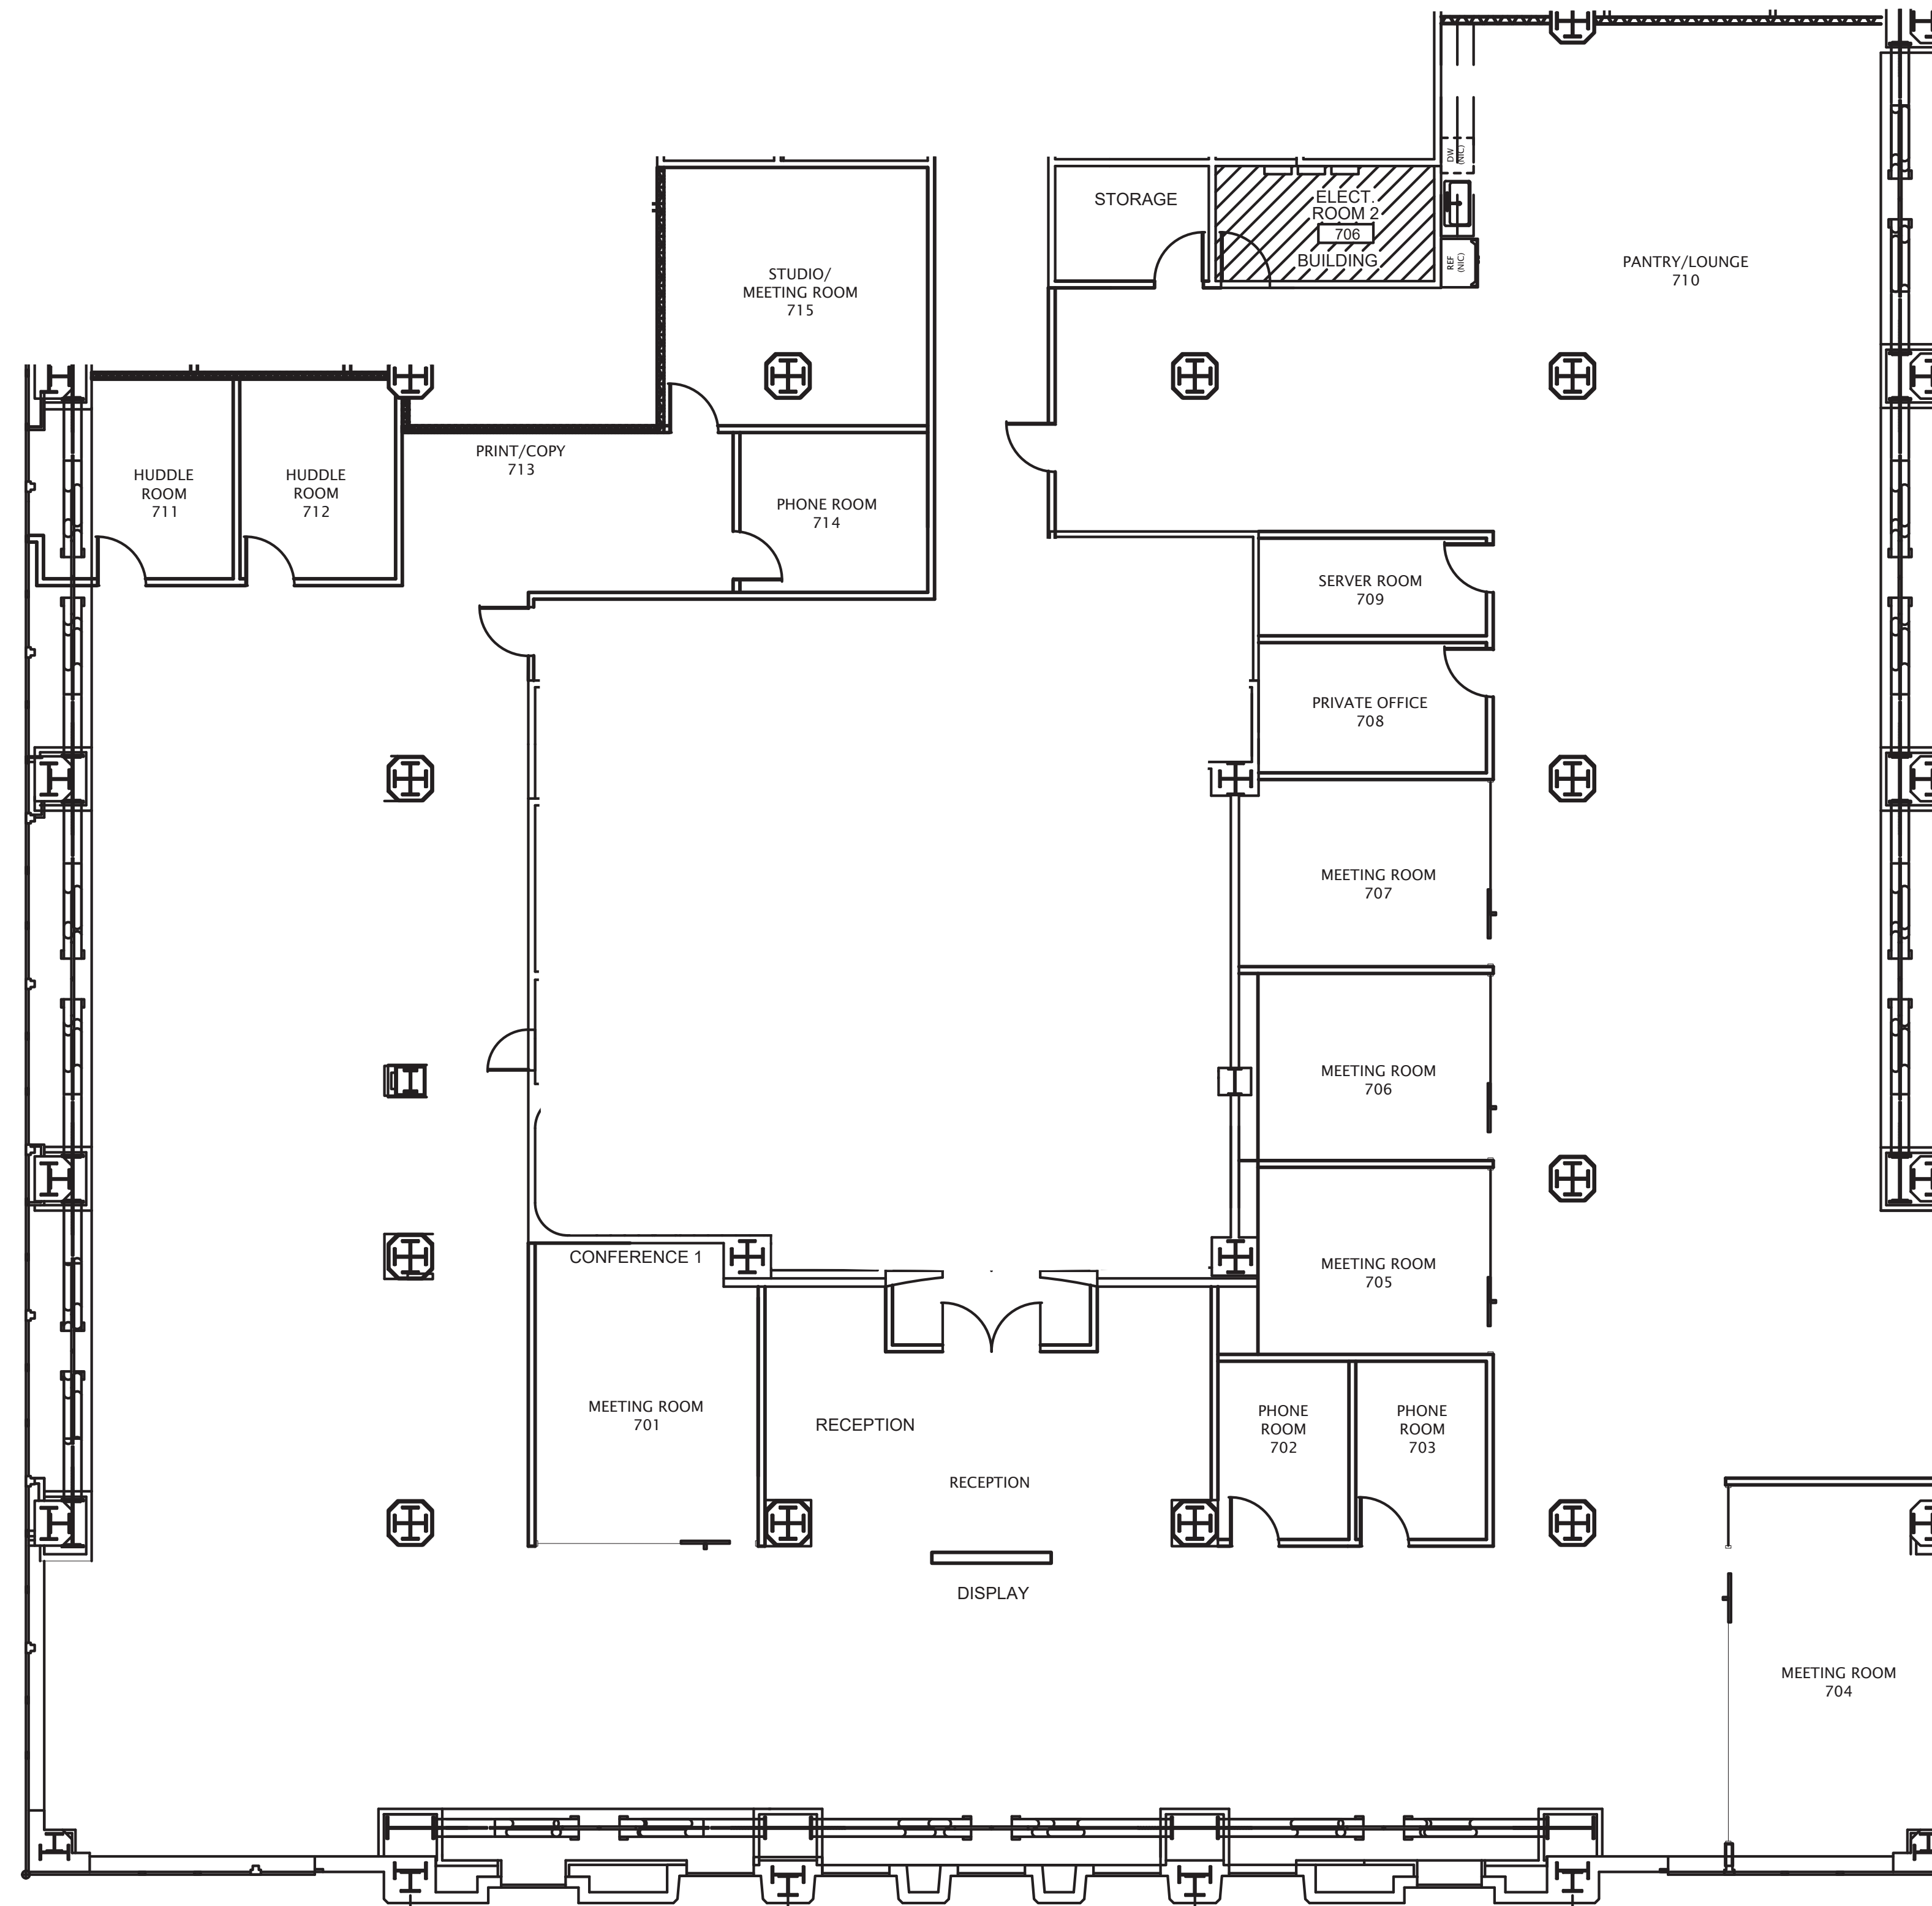


## AS-BUILT CONFIGURATION

- OFFICES..... 1
- RECEPTION..... 1
- CONFERENCE ROOMS..... 10
- KITCHEN..... 1
- OPEN WORK AREA..... TBD

*Not to scale, furniture and appliances not included*

## KEY PLAN

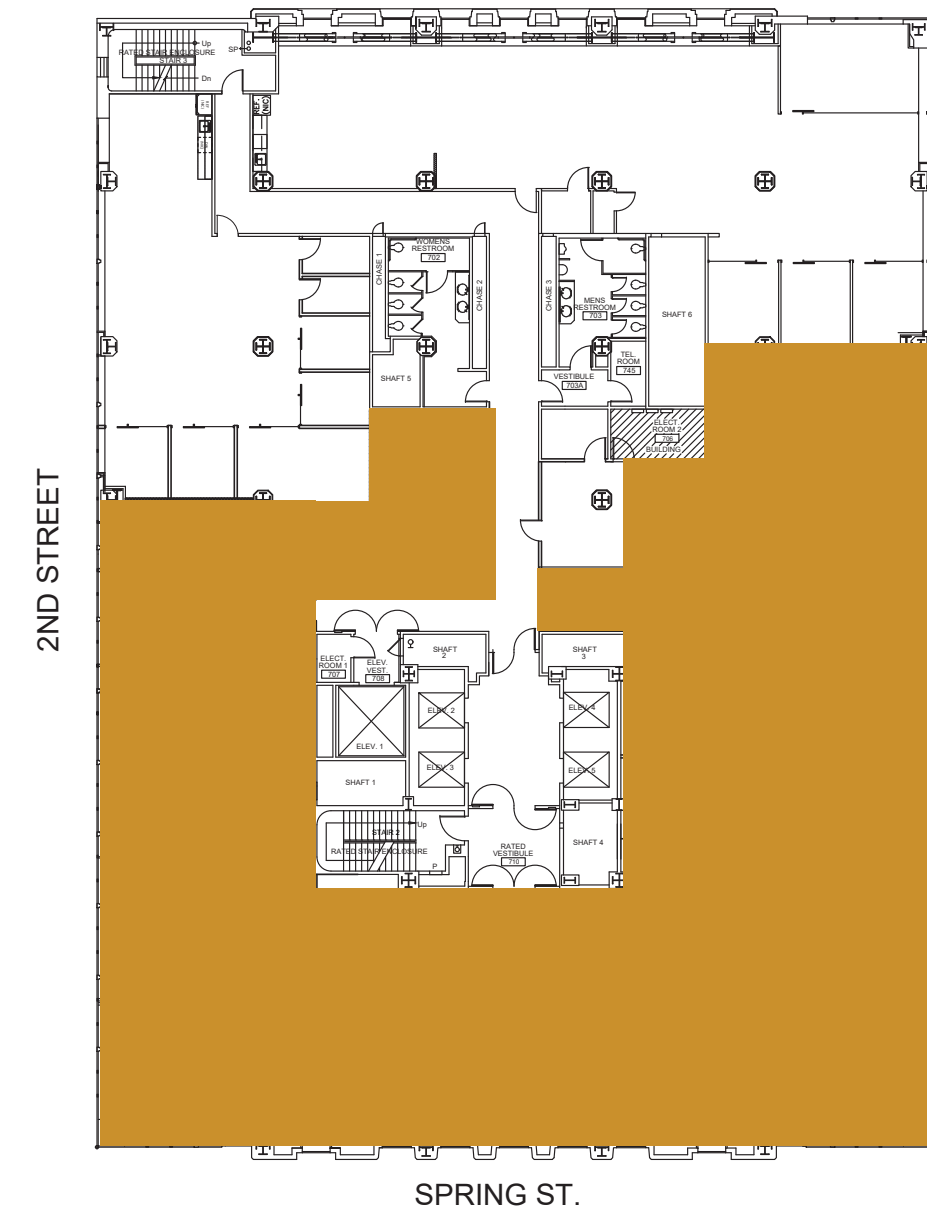

For leasing information please contact:  
Andrew D. Tashjian  
213.955.5148  
andrew.tashjian@cushwake.com