SUITE: 750


RSF: 3,467


AS-BUILT CONFIGURATION


| OFFICES | 3 |
|------------------|-------|
| RECEPTION | 1 |
| CONFERENCE ROOMS | 1 |
| KITCHEN | 1 |
| OPEN WORK AREA | +/-20 |

Not to scale, furniture and appliances not included

KEY PLAN

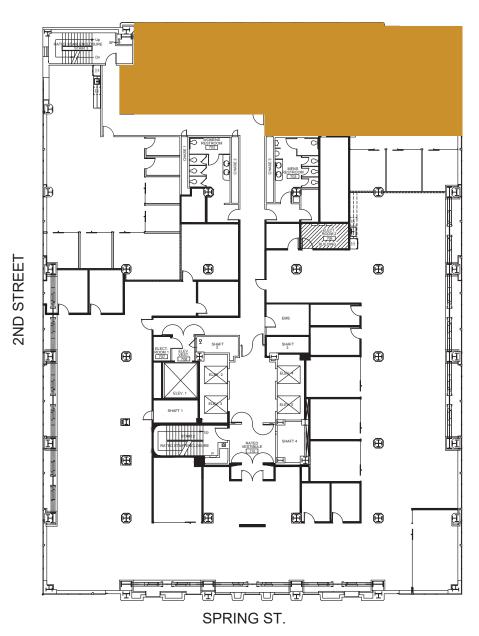

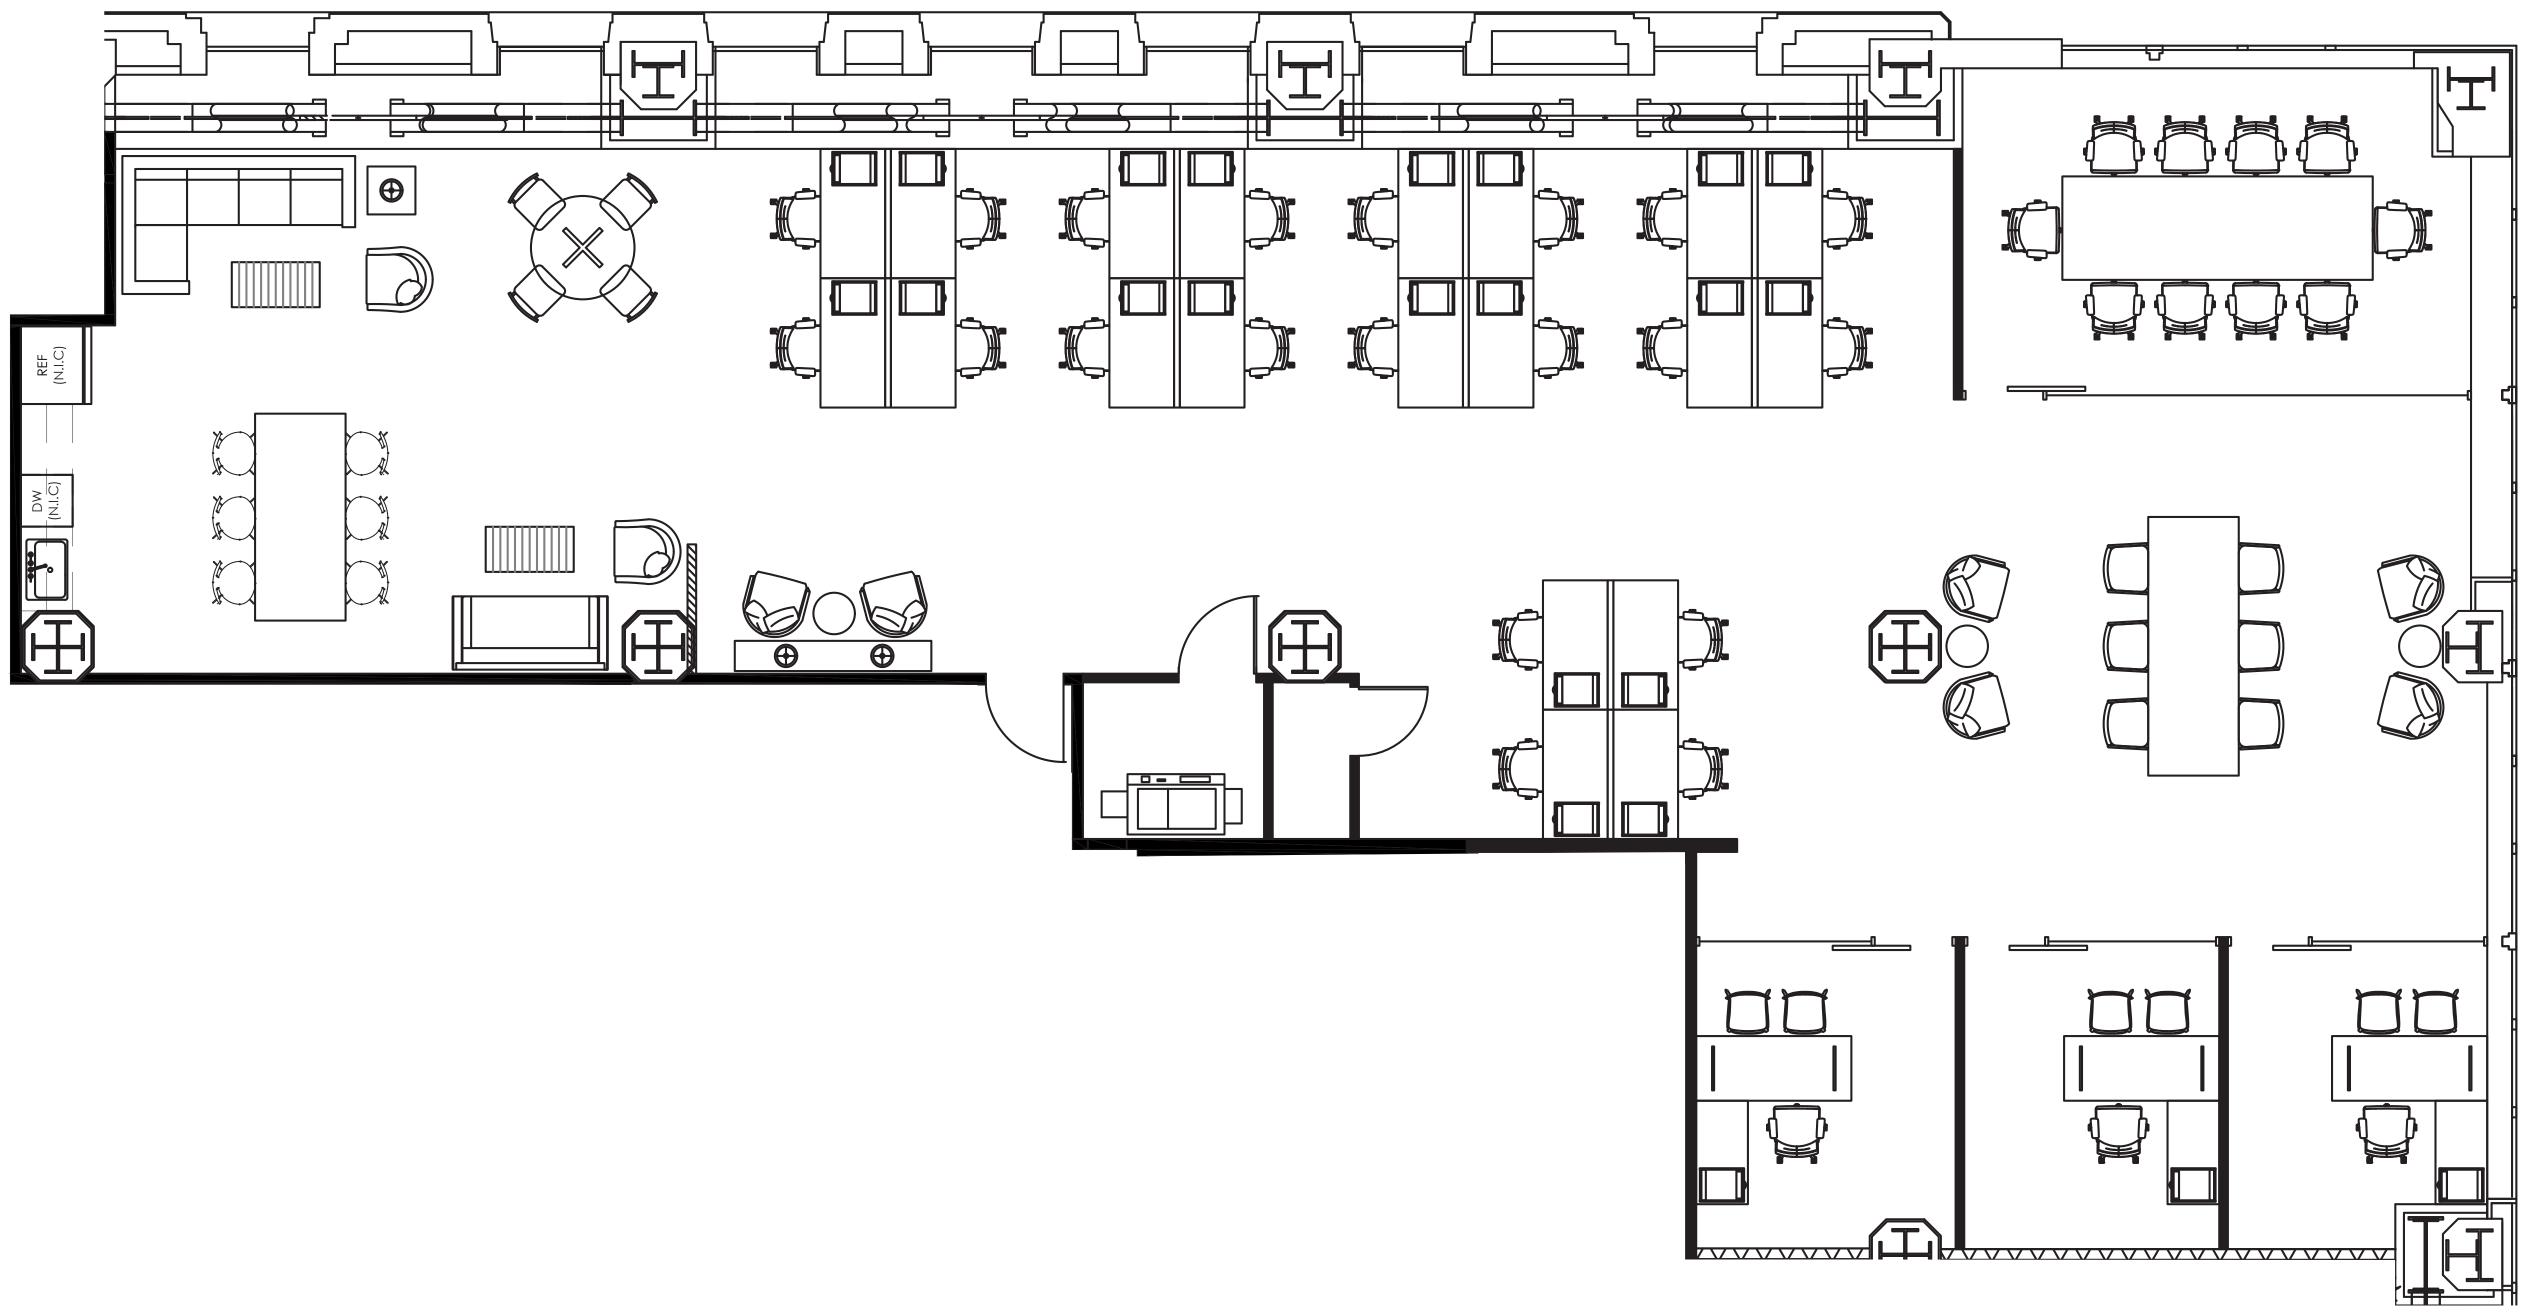

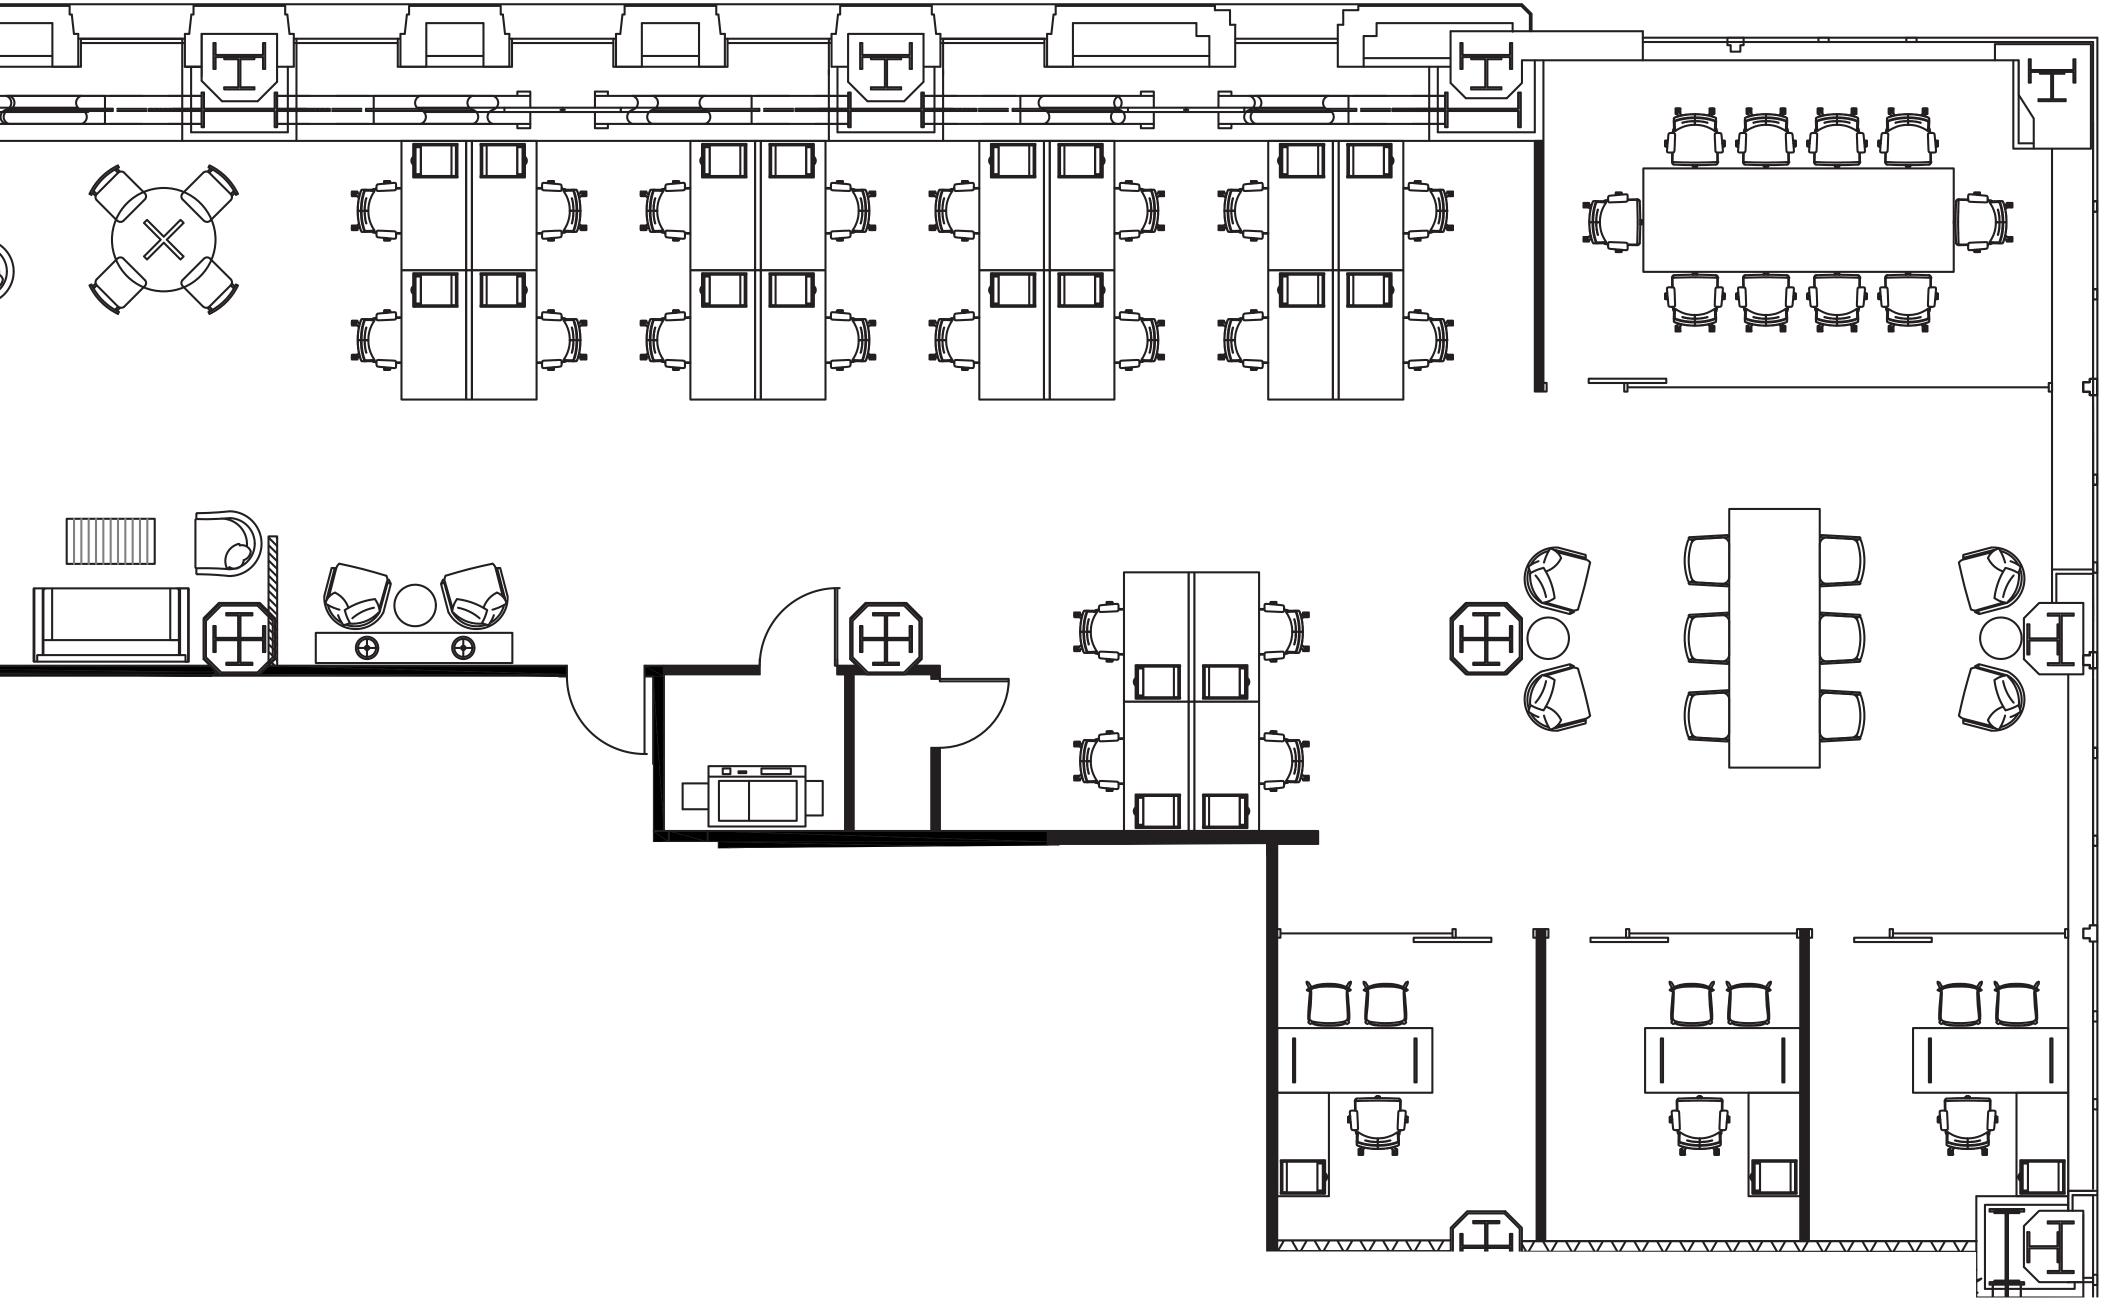

ONNI TIMES SQUARE EST. 1935

