
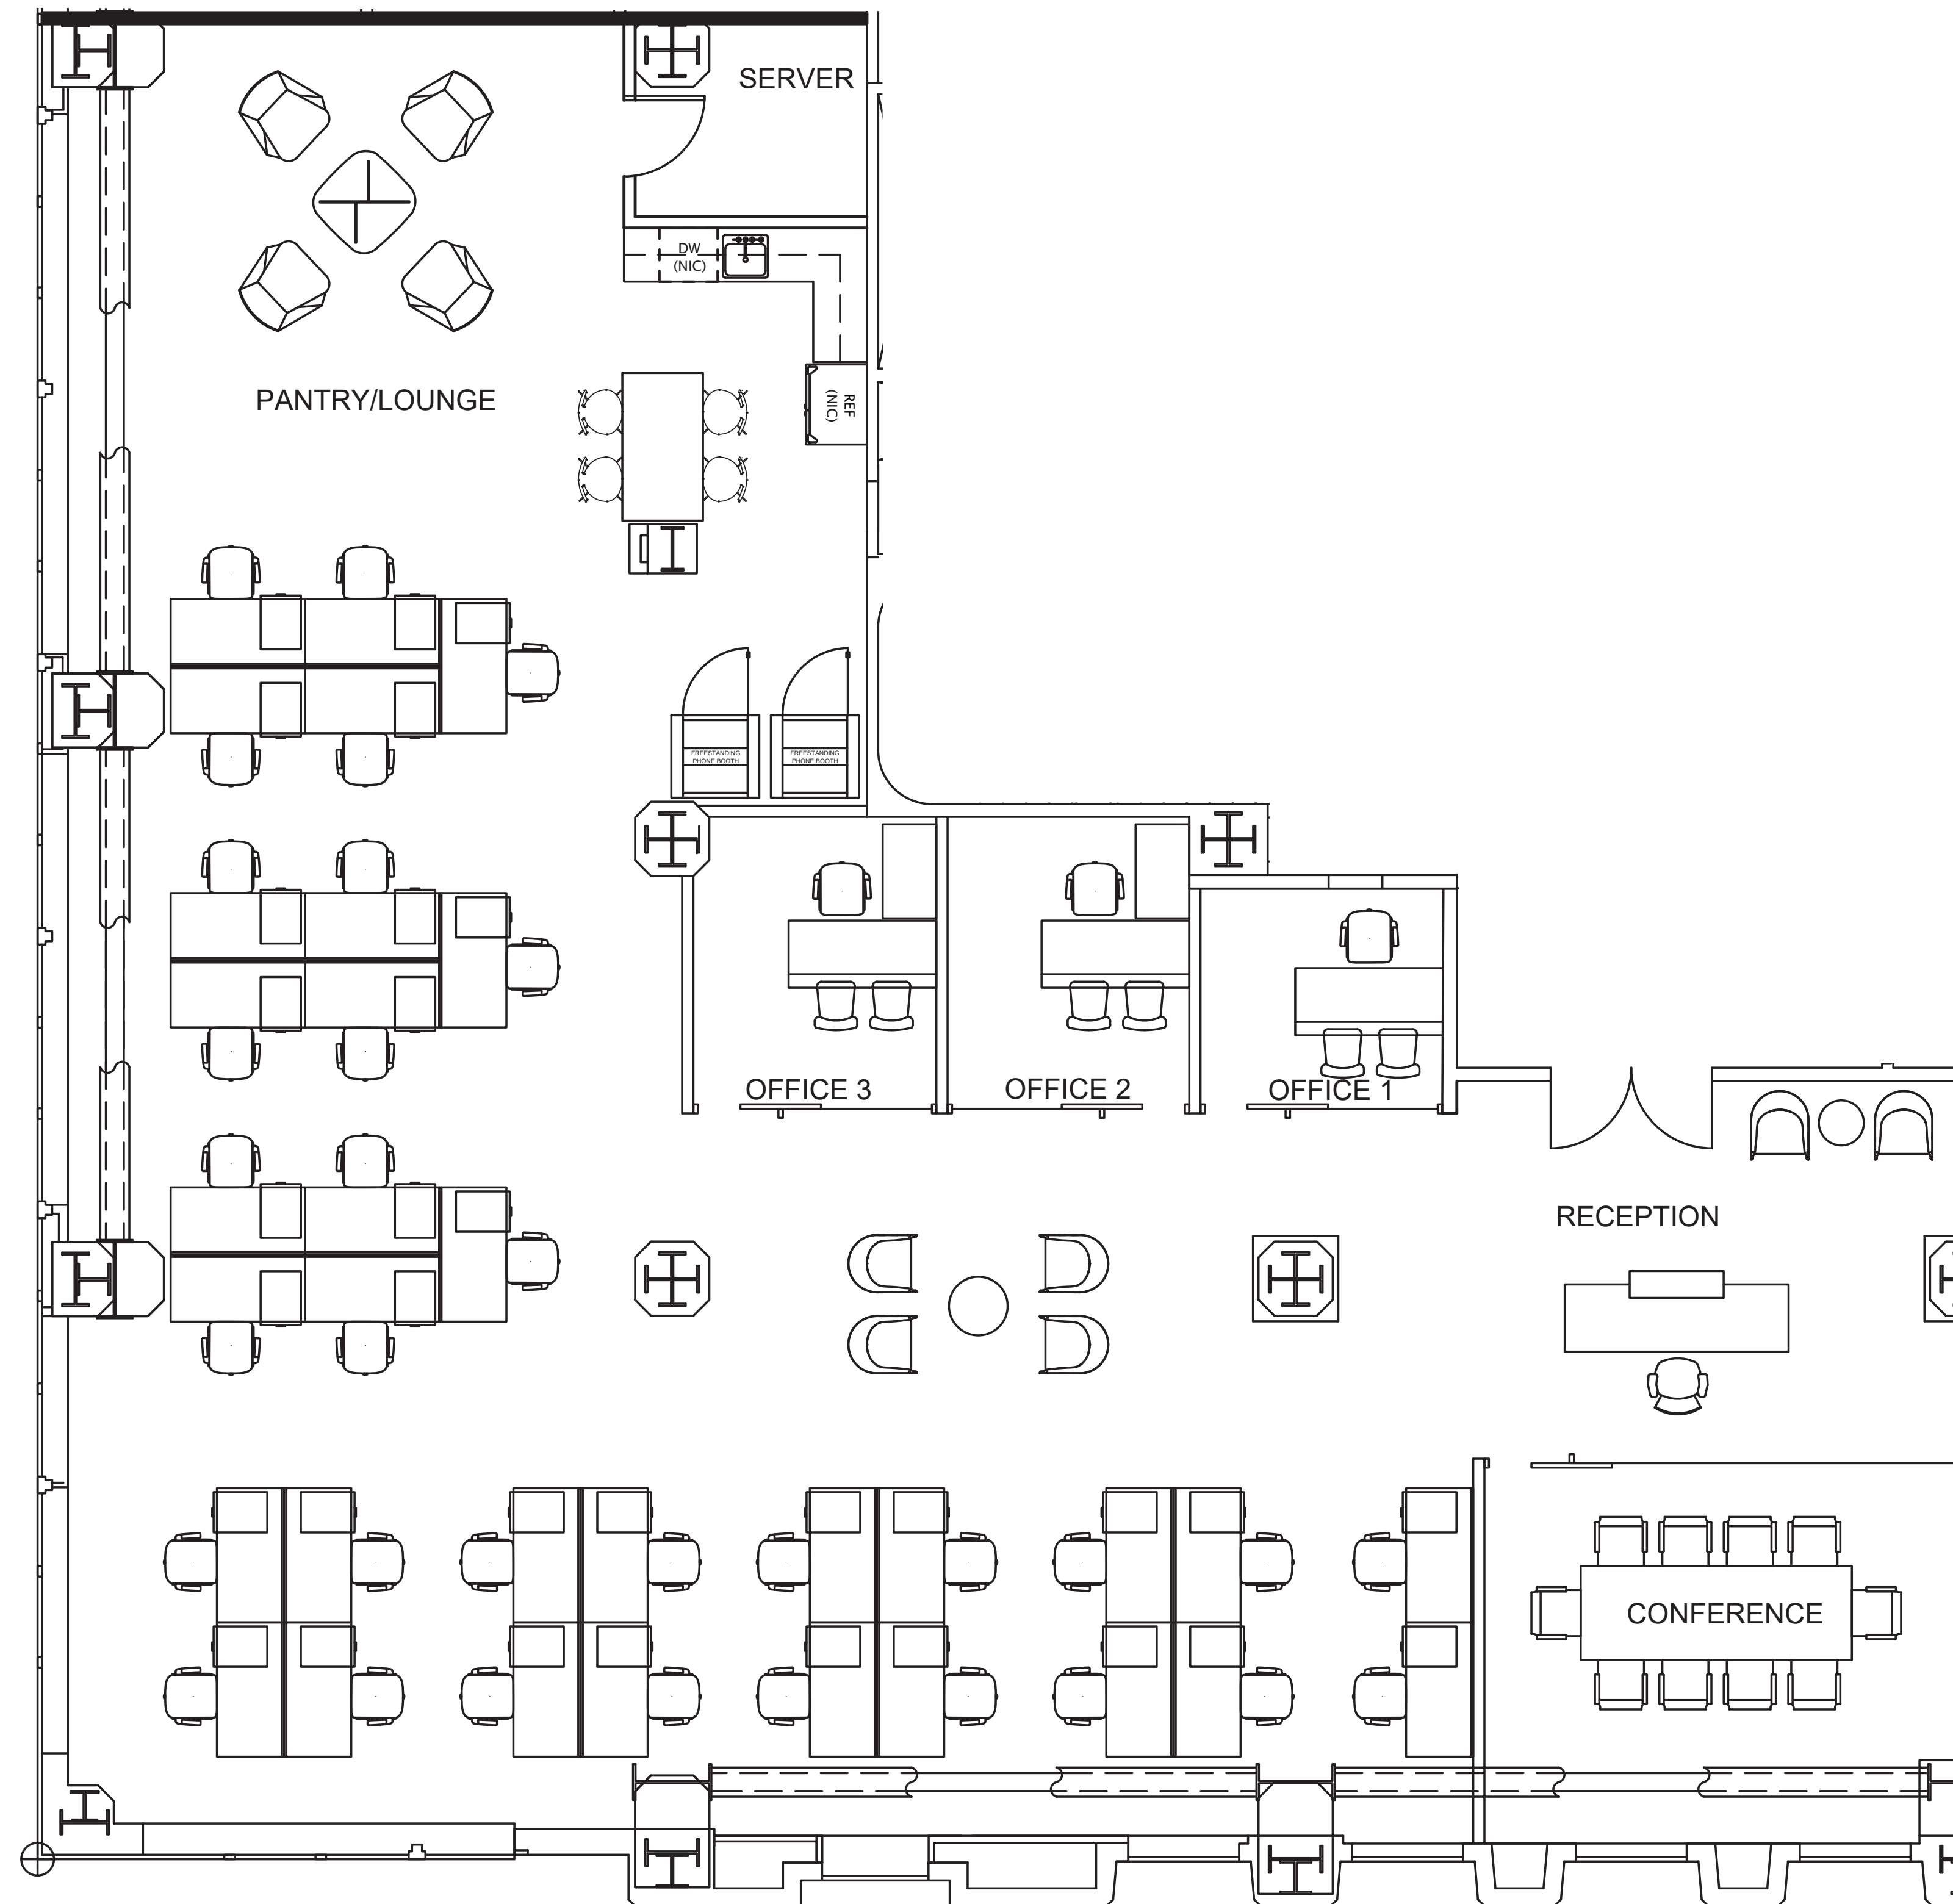


AS-BUILT CONFIGURATION

OFFICES.....	3
RECEPTION.....	1
CONFERENCE ROOMS.....	1
KITCHEN.....	1
OPEN WORK AREA.....	+/- 33

Not to scale, furniture and appliances not included

KEY PLAN

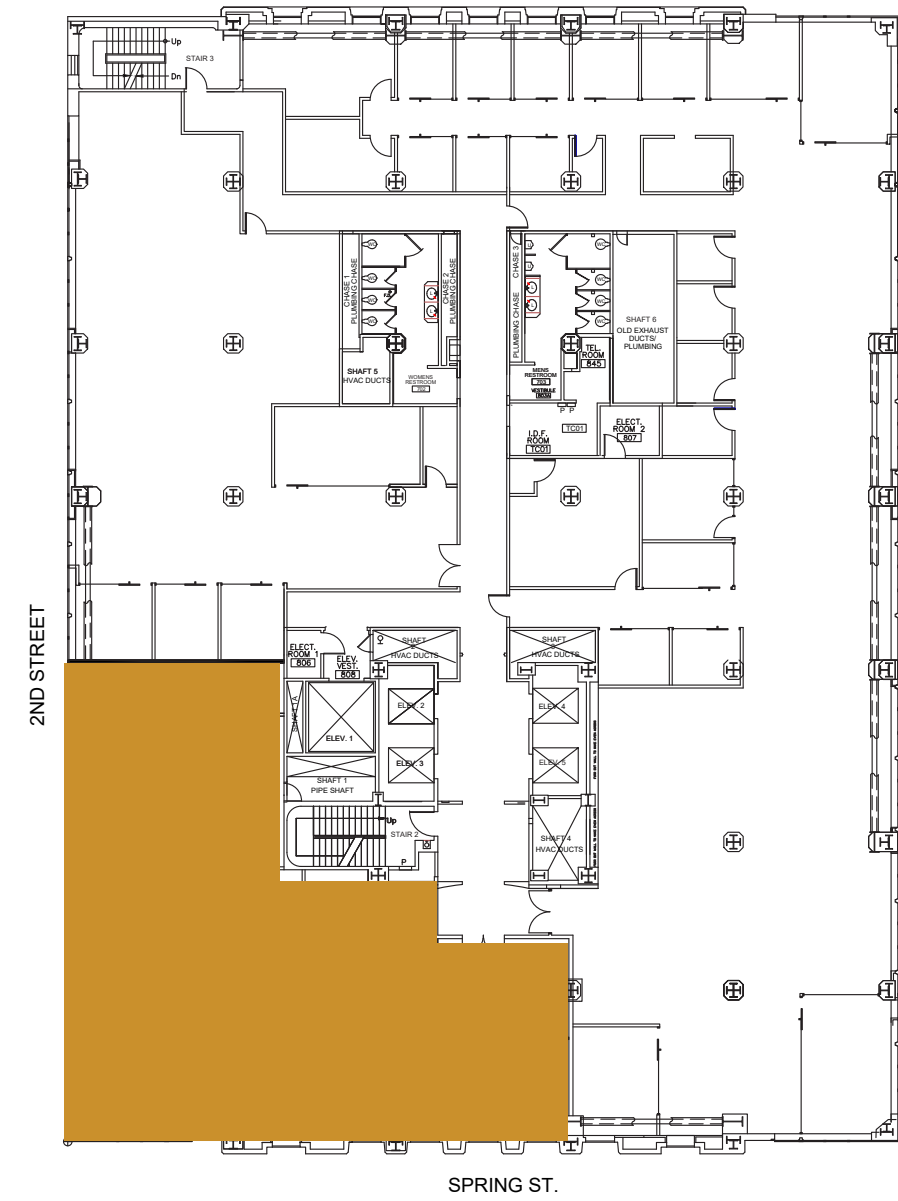

For leasing information please contact:
 Andrew D. Tashjian
 213.955.5148
 andrew.tashjian@cushwake.com