

SUITE: 200

RSF: 24,753

ONNI TIMES SQUARE


EST. 1935

AS-BUILT CONFIGURATION

OFFICES.....	9
RECEPTION.....	N/A
CONFERENCE ROOMS.....	2
KITCHEN.....	1
OPEN WORK AREA.....	+/-123

Not to scale, furniture and appliances not included

KEY PLAN

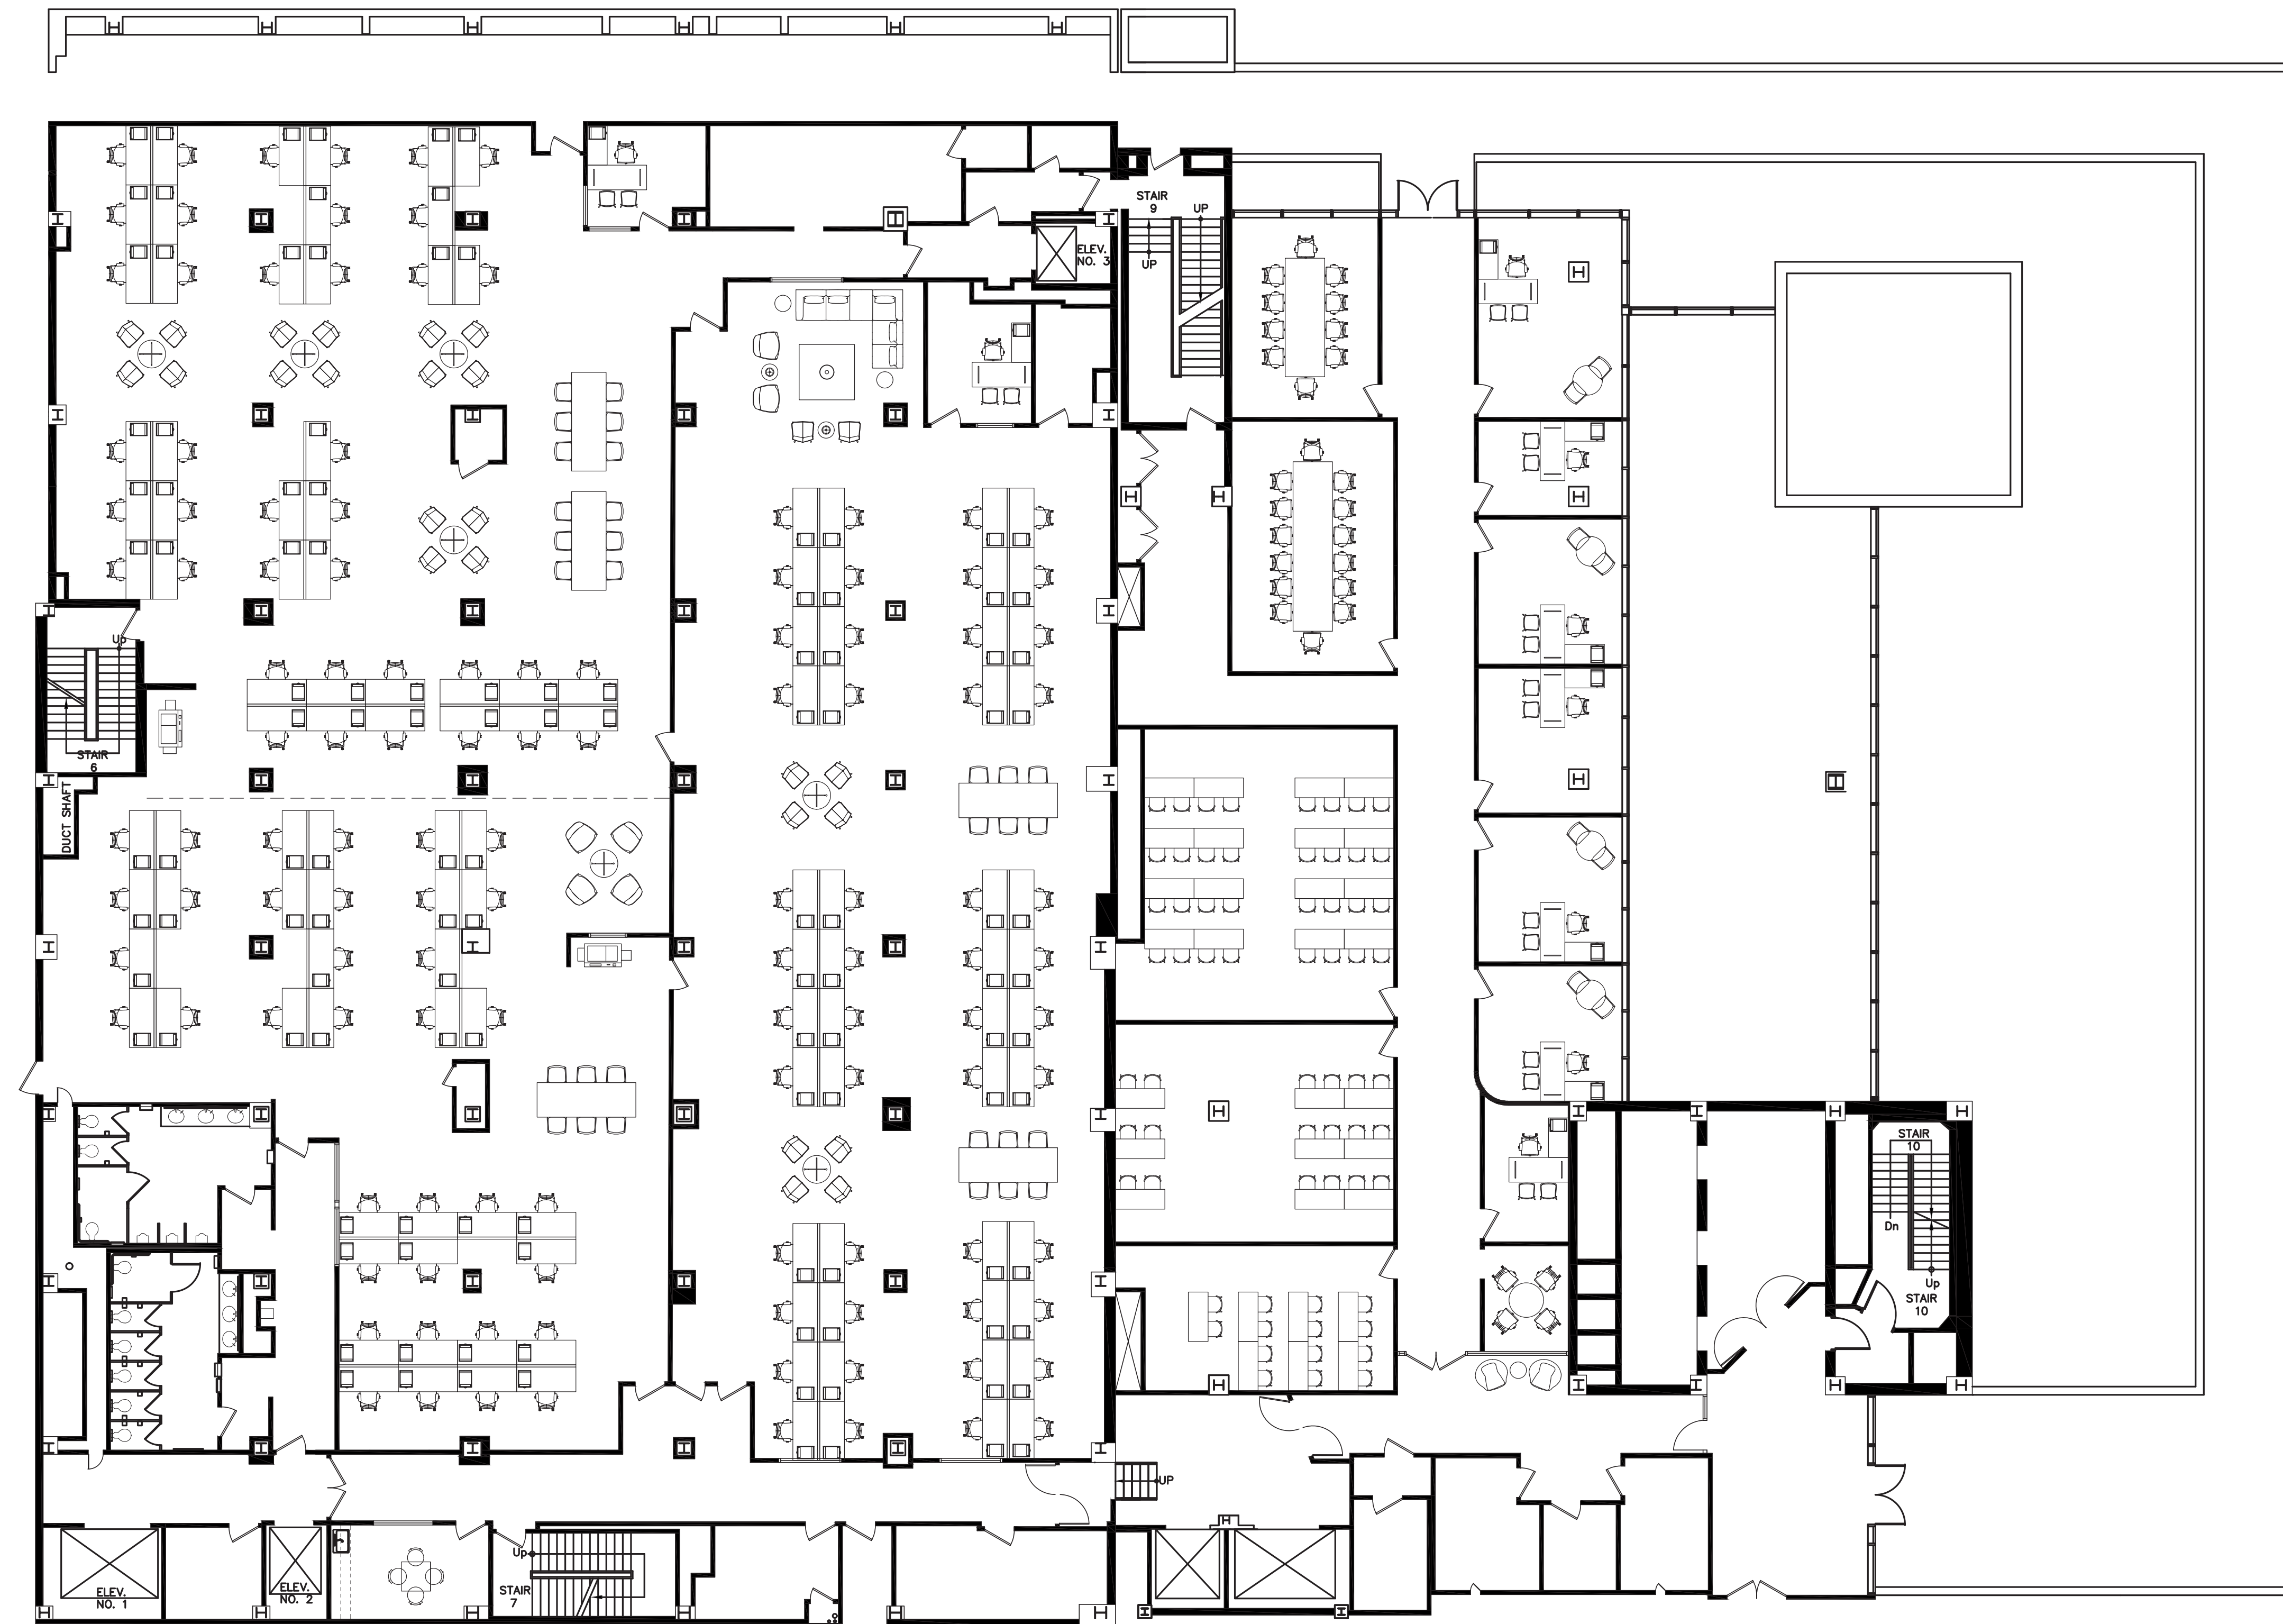

For leasing information please contact:

USALEASING@ONNI.COM

(213) 629-2041

