
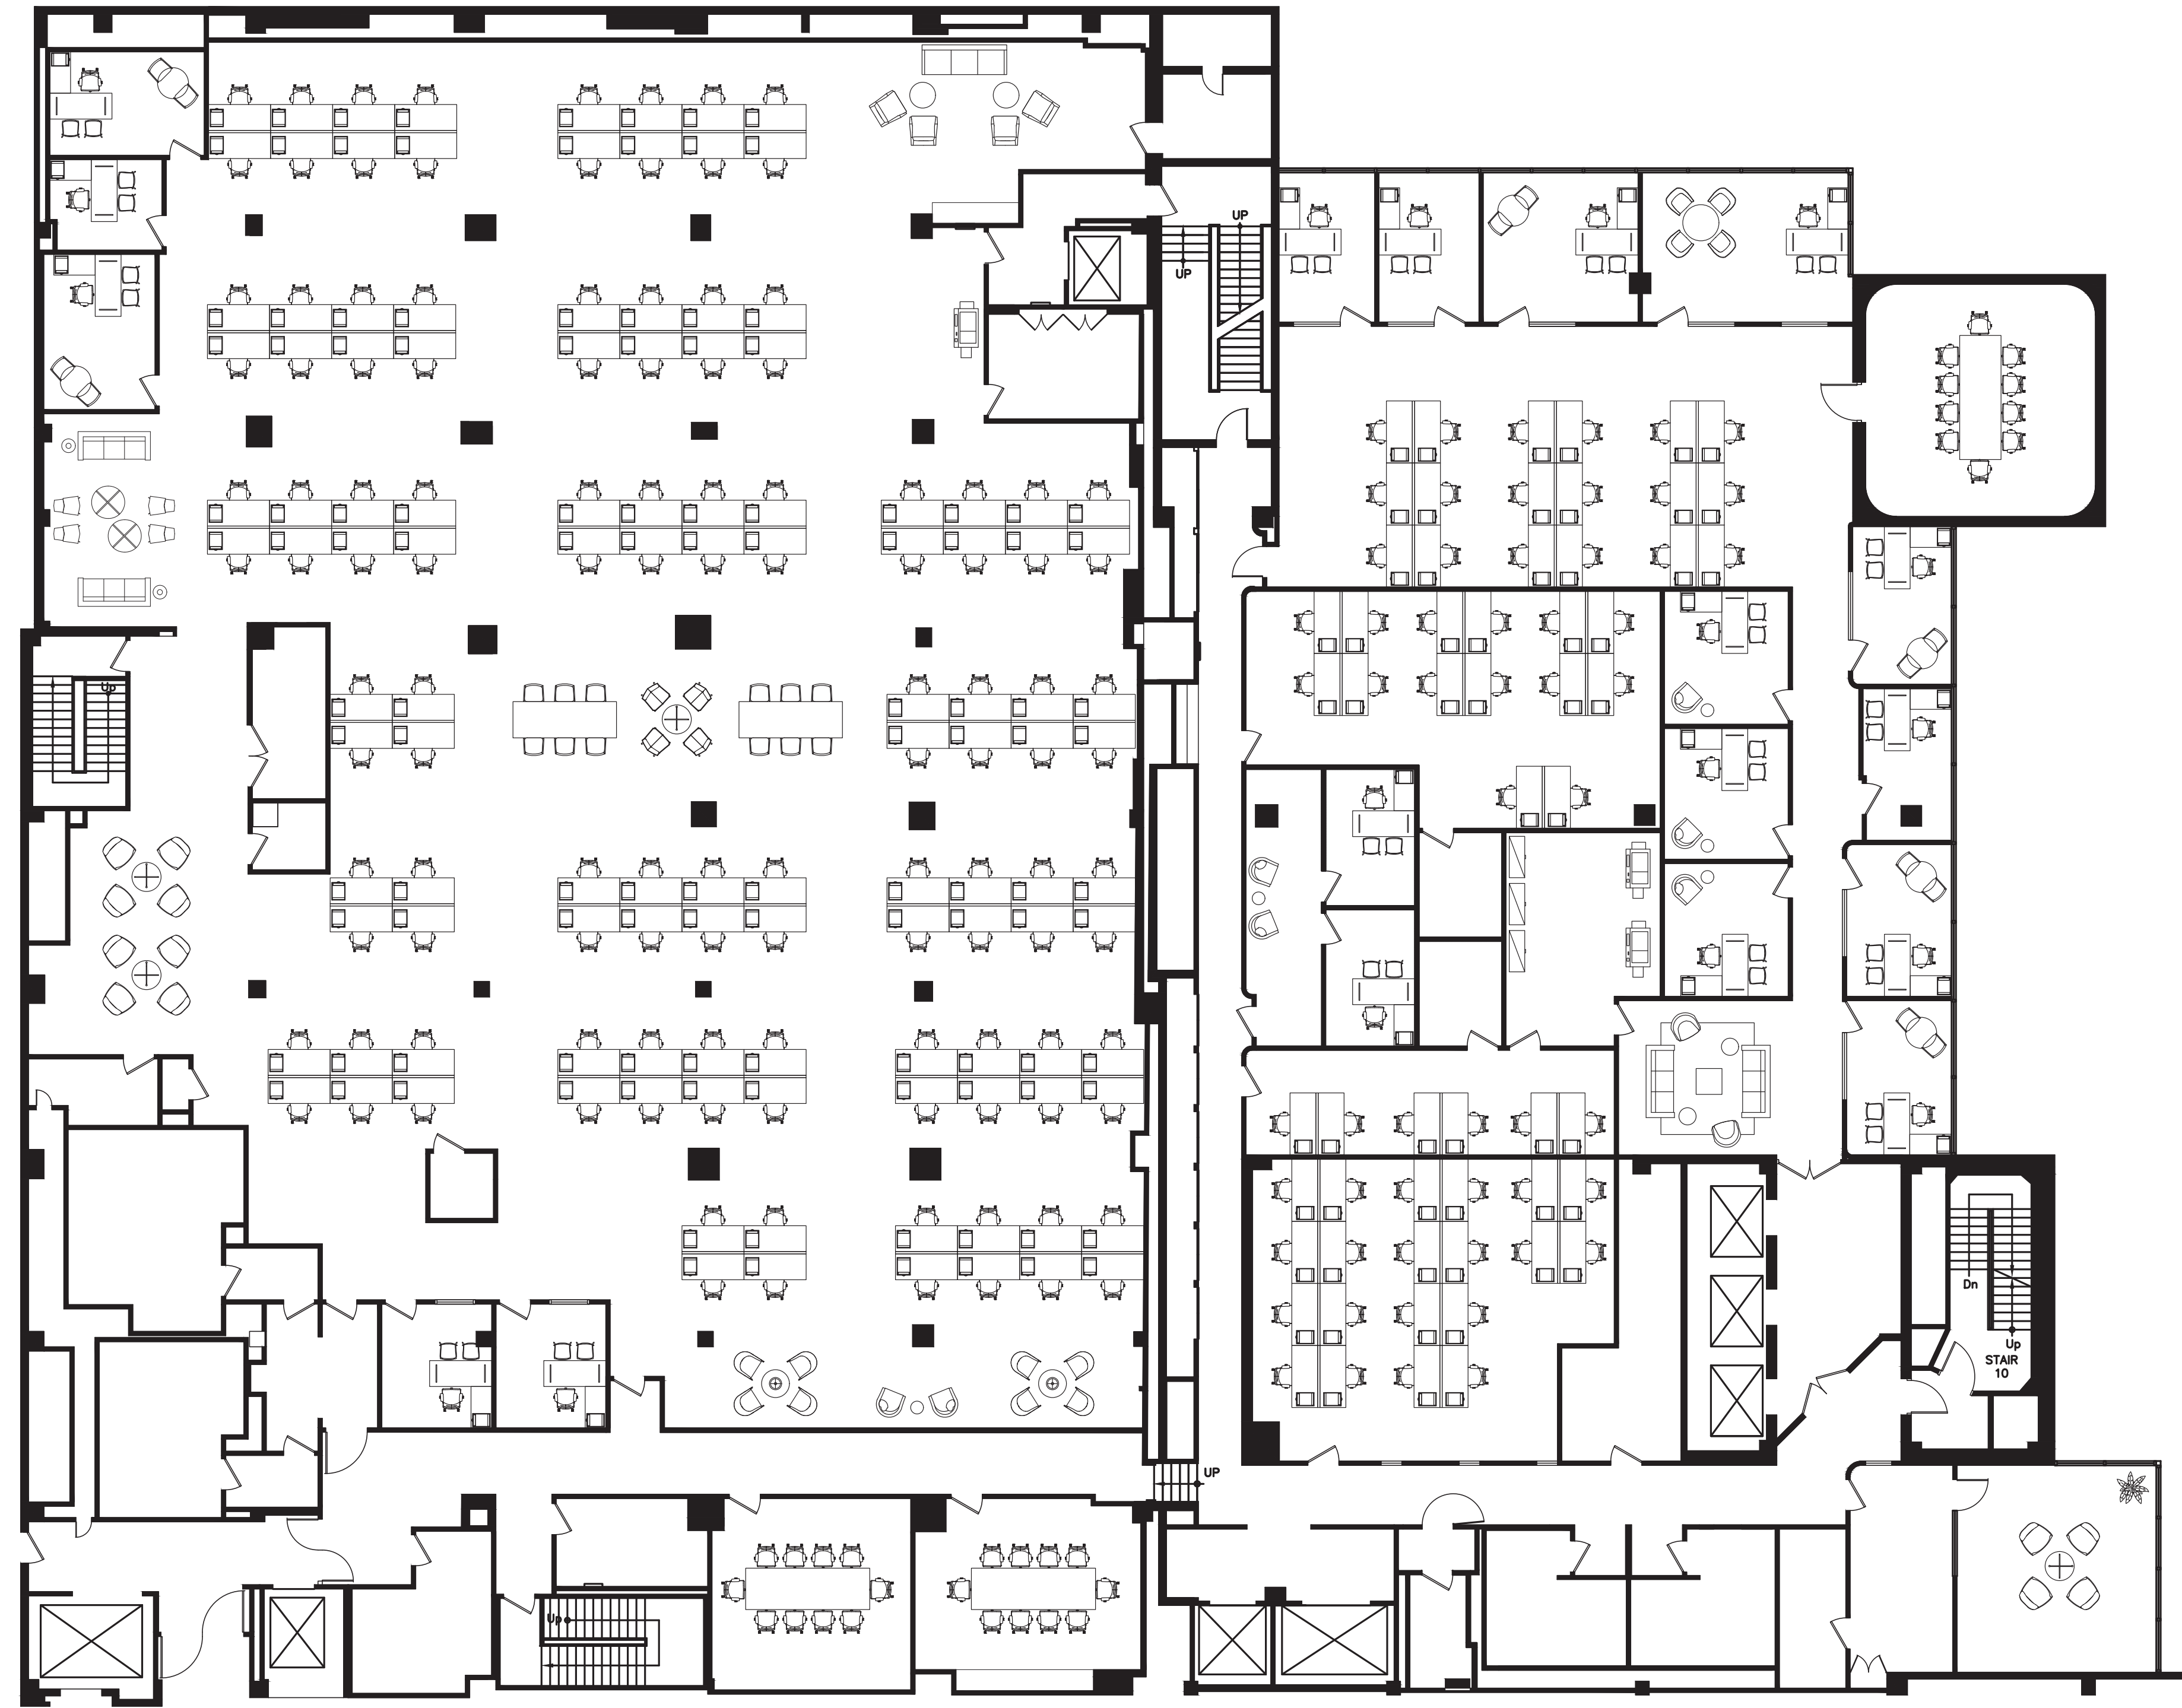


AS-BUILT CONFIGURATION

OFFICES.....	18
RECEPTION.....	N/A
CONFERENCE ROOMS.....	3
KITCHEN.....	N/A
OPEN WORK AREA.....	+/-124

Not to scale, furniture and appliances not included

KEY PLAN

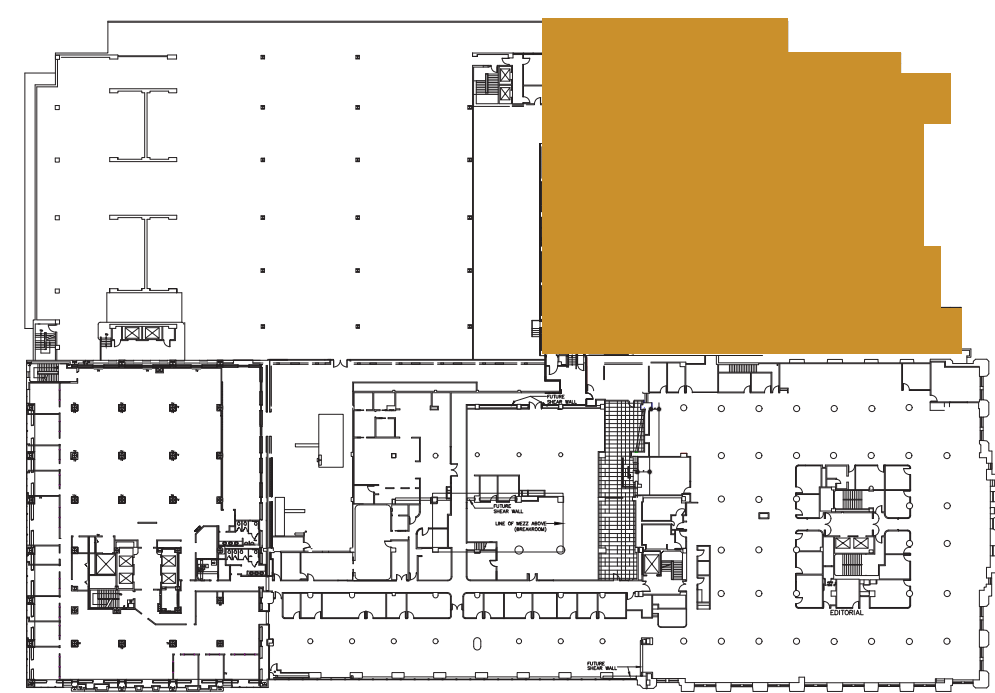

For leasing information please contact:

USALEASING@ONNI.COM
(213) 629-2041