SUITE: 200

RSF: 24,520

ONNI TIMES SQUARE
EST. 1935

AS-BUILT CONFIGURATION

OFFICES..... TBD

RECEPTION..... TBD

CONFERENCE ROOMS.....TBD

KITCHEN..... TBD

OPEN WORK AREA.....TBD

Not to scale, furniture and appliances not included

KEY PLAN

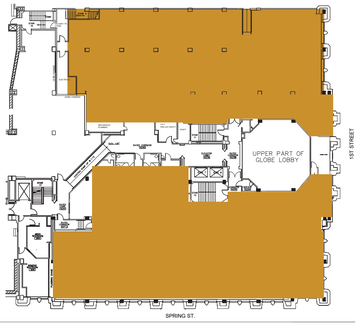

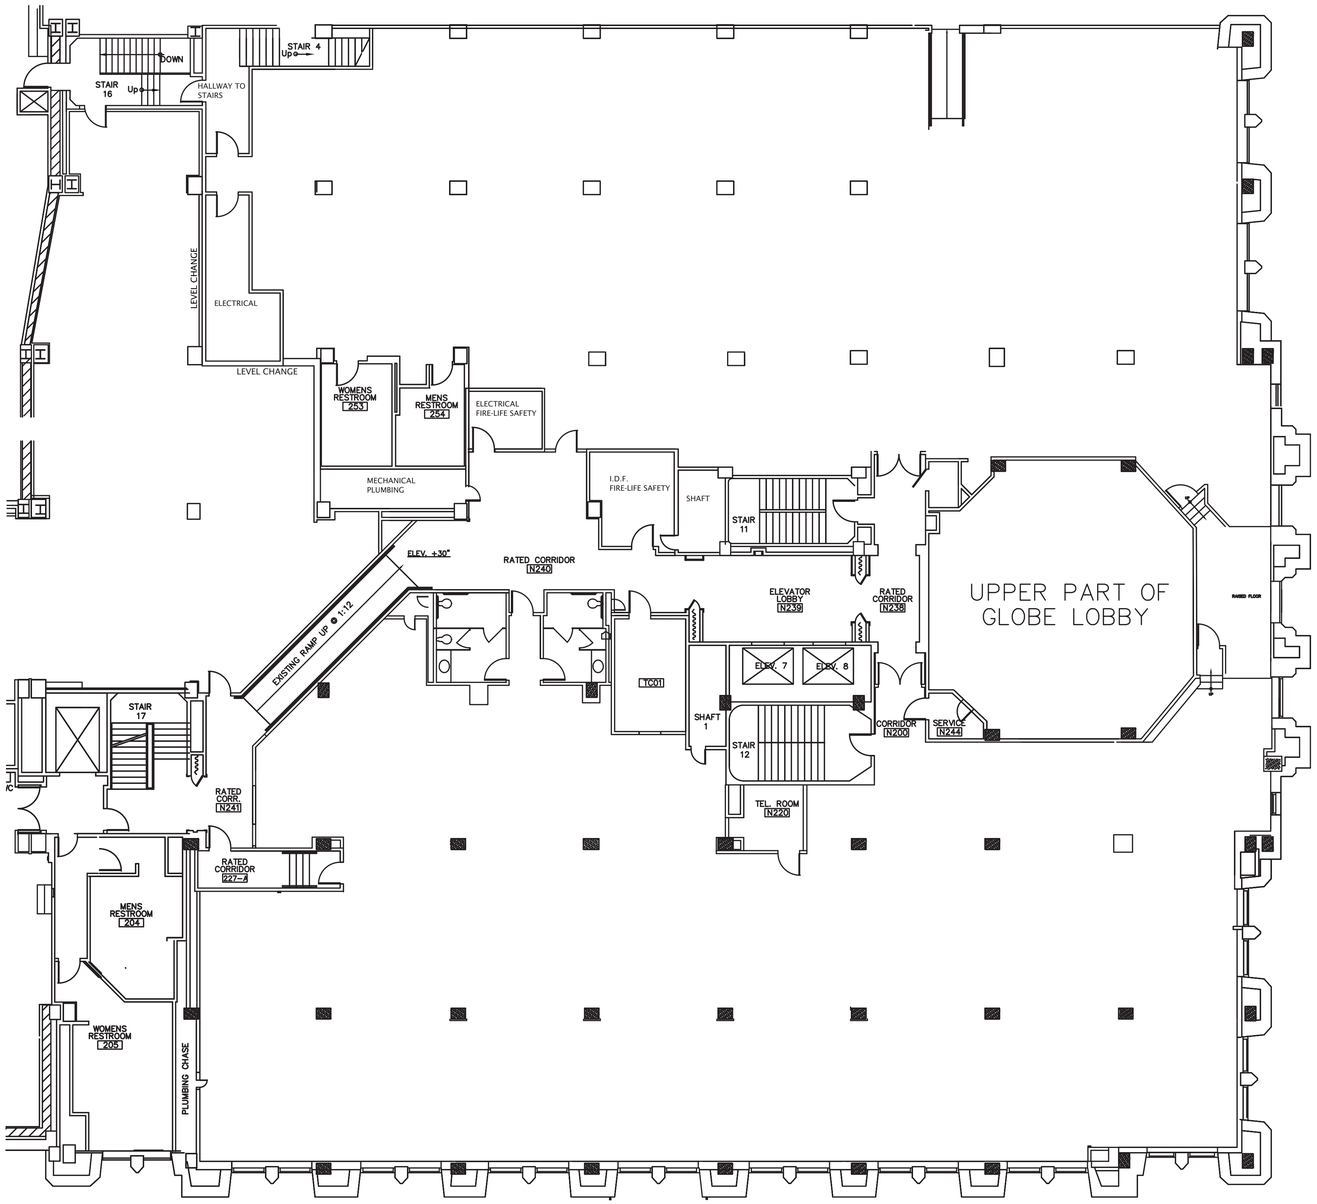

For leasing information please contact:
Andrew D. Tashjian
213.955.5148
andrew.tashjian@cushwake.com

onni group