# SUITE: 200 RSF: 19,330

ONNI TIMES SQUARE
EST. 1935

## AS-BUILT CONFIGURATION

OFFICES..... TBD

RECEPTION..... TBD

CONFERENCE ROOMS..... TBD

KITCHEN..... TBD

OPEN WORK AREA..... TBD

*Not to scale, furniture and appliances not included*
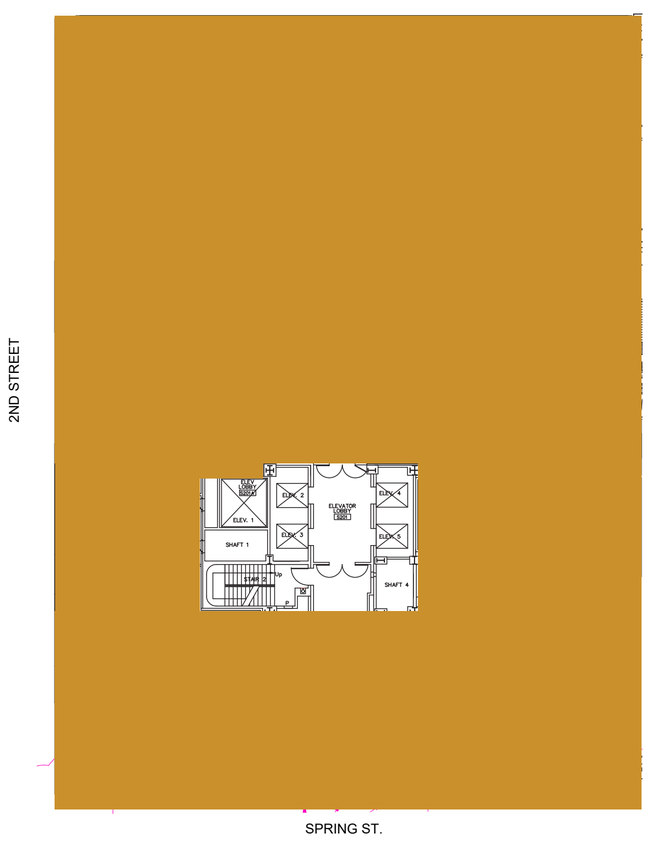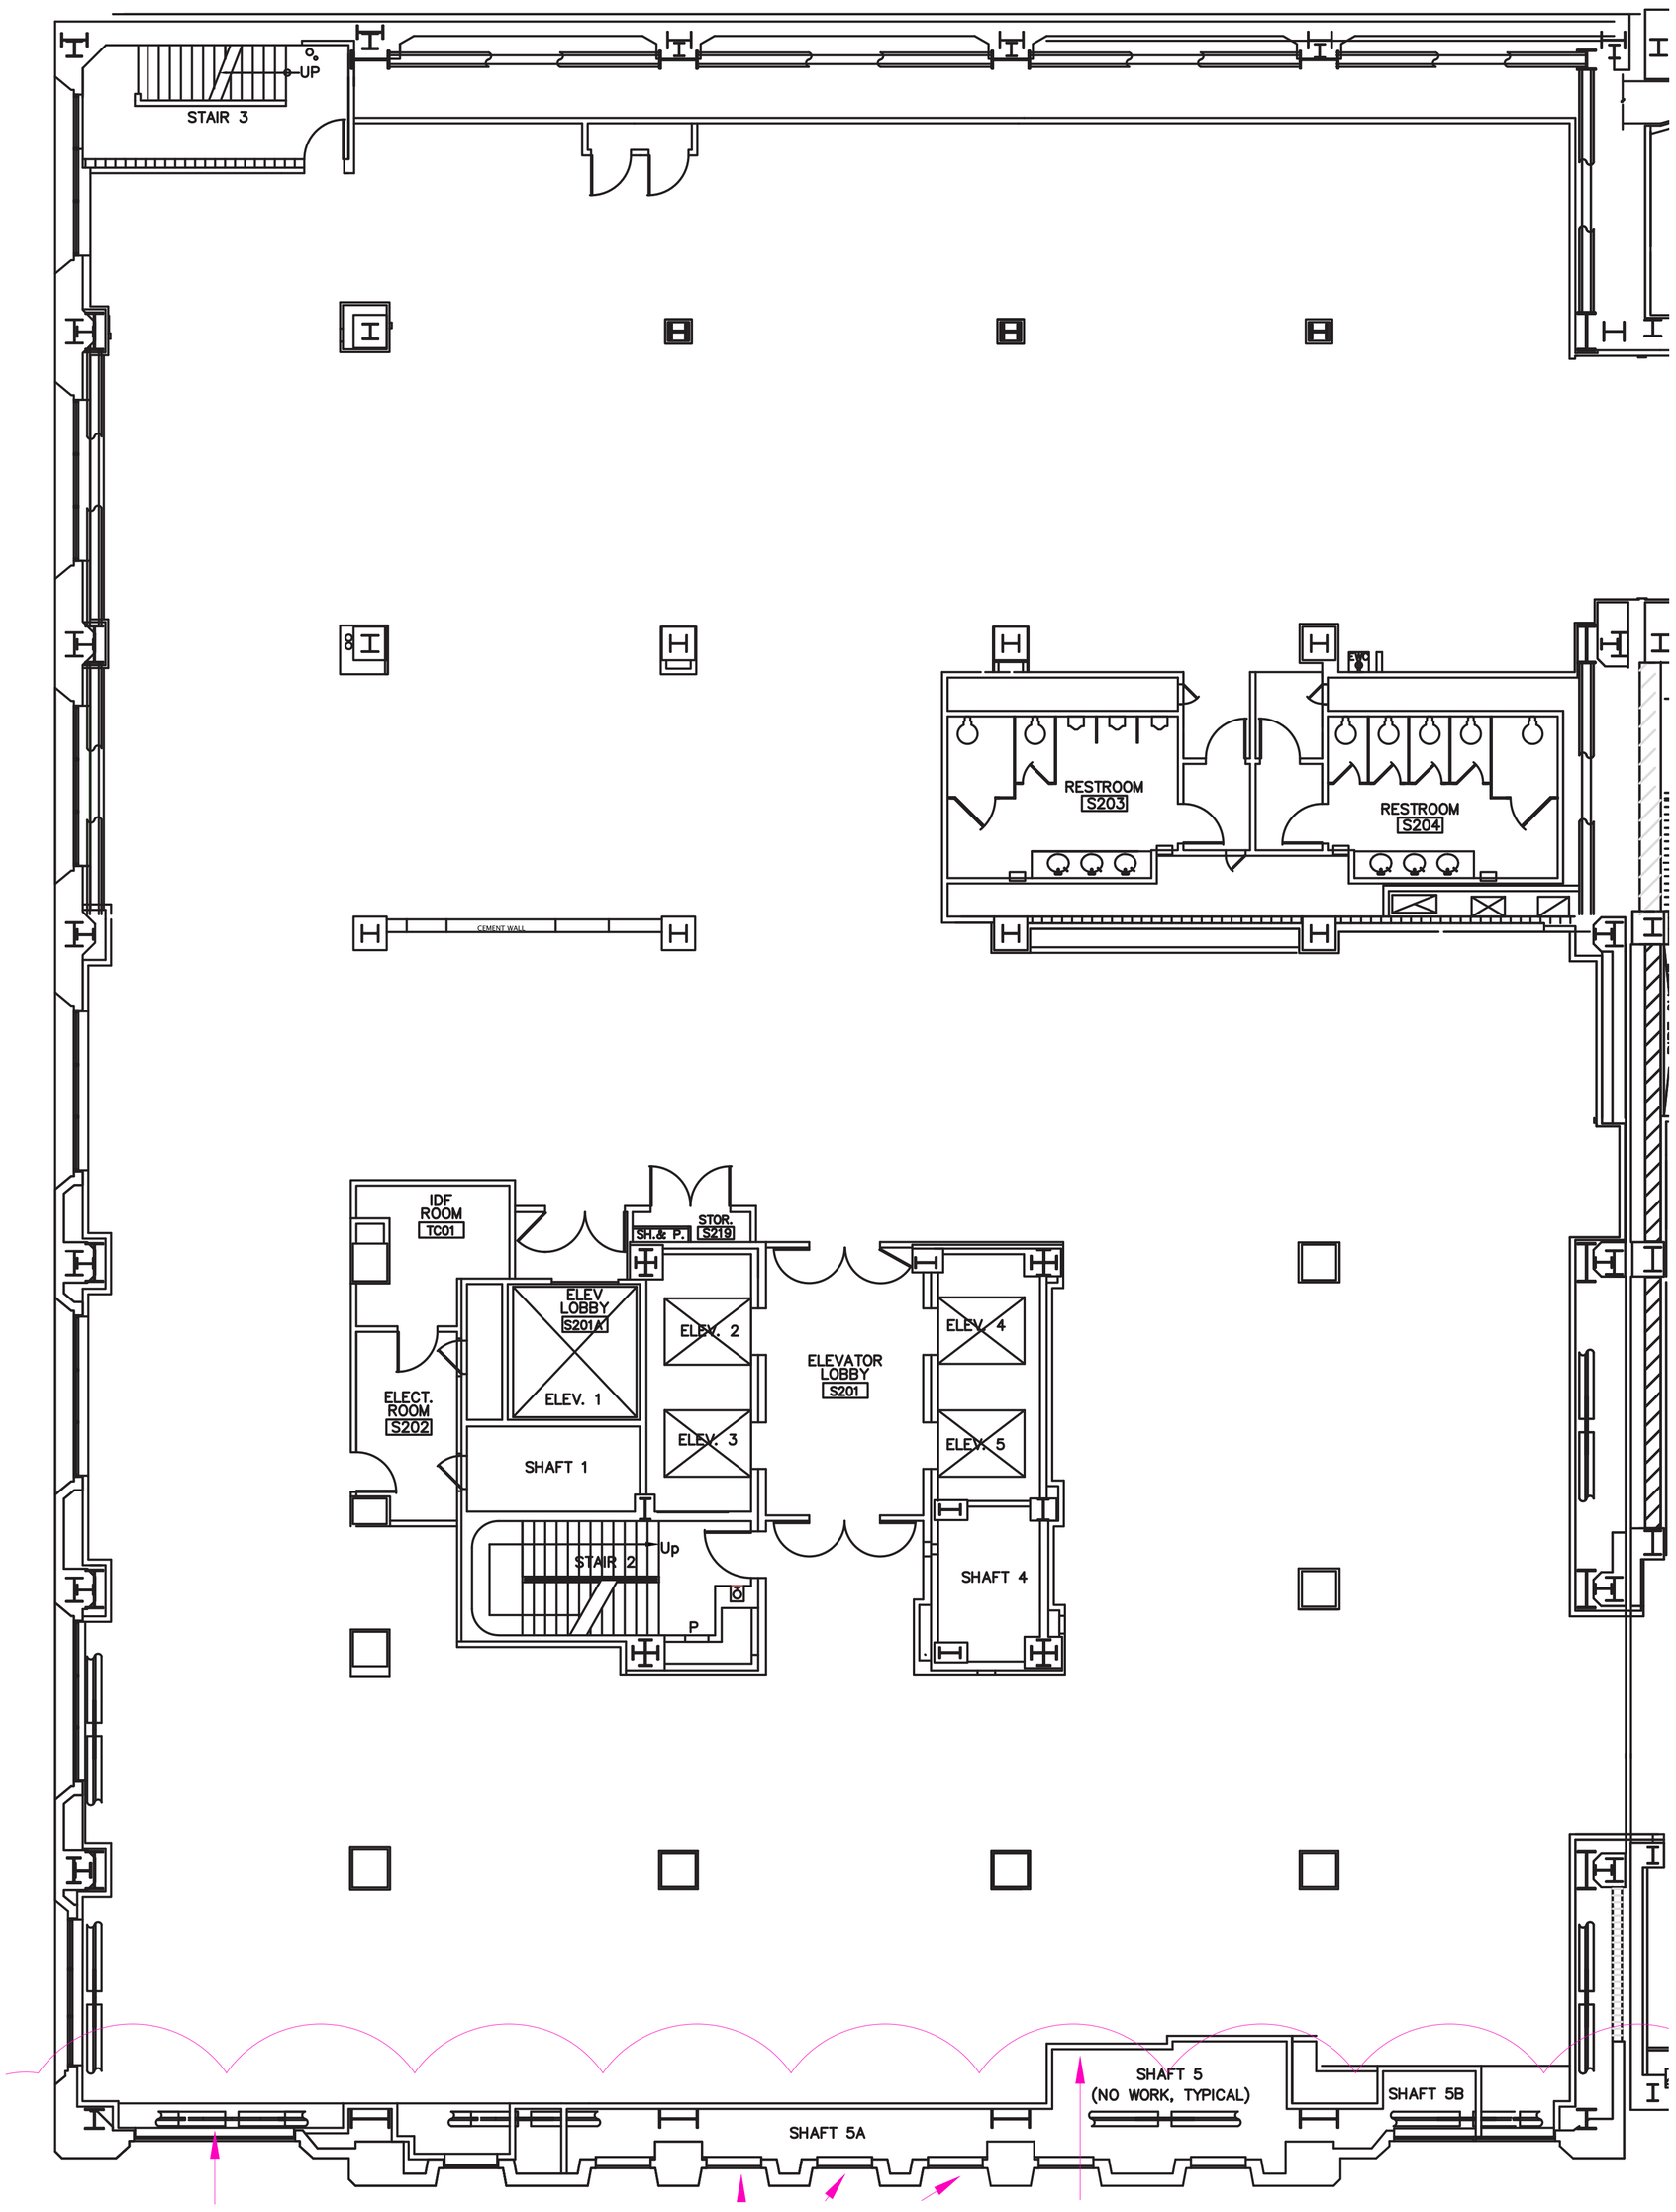
## KEY PLAN